


STATE ENGINEER
Salem, Oregon

Well Record *Polk* STATE WELL NO. *7/4W-26E(1)*
COUNTY *Polk*
2104 APPLICATION NO. GR-365

OWNER: *Restlawn Memory Gardens, Inc.* MAILING ADDRESS: *677 N. Cottage St.*
CITY AND STATE: *Salem, Oregon*
LOCATION OF WELL: Owner's No. *2*

SW 1/4 *NW* 1/4 Sec. *26* T. *7* S., R. *4* W., W.M.
Bearing and distance from section or subdivision
corner *2000' S. & 500' E. from NW cor. Sec. 26*

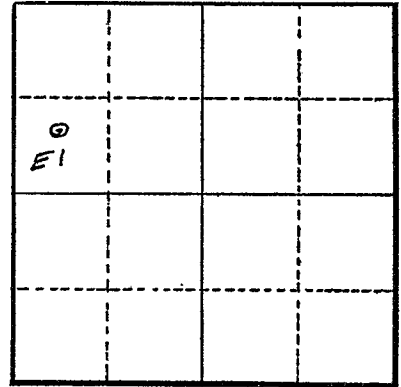

Altitude at well *238 ft.*

TYPE OF WELL: *drilled* Date Constructed *Mar. 1954*
Depth drilled *155* Depth cased *155*

Section *26*

CASING RECORD: *8 inch*

FINISH:

AQUIFERS:

WATER LEVEL: *140 ft.*

PUMPING EQUIPMENT: Type *Small jet* H.P. *2*
Capacity _____ G.P.M.

WELL TESTS:
Drawdown _____ ft. after _____ hours _____ G.P.M.
Drawdown _____ ft. after _____ hours _____ G.P.M.

USE OF WATER *irrigation* Temp. _____ °F., 19 _____

SOURCE OF INFORMATION *Ground Water Registration Record*

DRILLER or DIGGER *E. J. Studebaker*

ADDITIONAL DATA:
Log *No* Water Level Measurements _____ Chemical Analysis _____ Aquifer Test _____

REMARKS: