


STATE ENGINEER
Salem, Oregon

Well Record **Polk** STATE WELL NO. 7/4W-26M(1)
COUNTY Polk
APPLICATION NO. GR-365

OWNER: Restlawn Memory Gardens, Inc. MAILING ADDRESS: 677 N. Cottage St.
CITY AND STATE: Salem, Oregon
LOCATION OF WELL: Owner's No. 1

NW $\frac{1}{4}$ SW $\frac{1}{4}$ Sec. 26 T. 7 S., R. 4 W., W.M.
Bearing and distance from section or subdivision
corner 2800' S. & 1000' E. from NW cor. Sec. 26

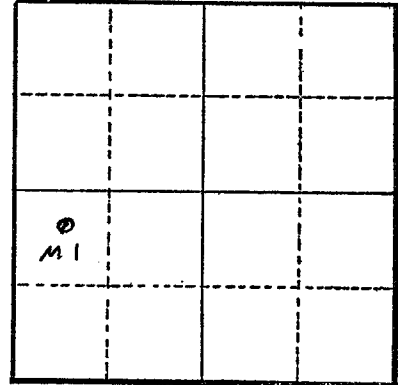

Section 26

Altitude at well 207 ft.

TYPE OF WELL: drilled Date Constructed Spring '53

Depth drilled 140 ft. Depth cased 140 ft.

CASING RECORD: 8 inch

FINISH:

AQUIFERS:

WATER LEVEL: 20 ft.

PUMPING EQUIPMENT: Type Small jet H.P. 1
Capacity 30 G.P.M.

WELL TESTS:
Drawdown ft. after hours G.P.M.
Drawdown ft. after hours G.P.M.

USE OF WATER irrigation Temp. °F., 19

SOURCE OF INFORMATION Ground Water Registration Record

DRILLER or DIGGER E. J. Studebaker

ADDITIONAL DATA:
Log No Water Level Measurements Chemical Analysis Aquifer Test

REMARKS: