

STATE ENGINEER
Salem, Oregon


Well Record *Polk* STATE WELL NO. *7/4W-27H(1)*
COUNTY *Polk*
2122 APPLICATION NO. *GR-365*

OWNER: Restlawn Memory Garden, Inc. MAILING ADDRESS: 677 N. Cottage St.

LOCATION OF WELL: Owner's No. 3 CITY AND STATE: Salem, Oregon

SE 1/4 NE 1/4 Sec. 27 T. 7 S., R. 4 W., W.M.

Bearing and distance from section or subdivision corner 2020' S. & 300' W. from NW cor. Sec. 26.

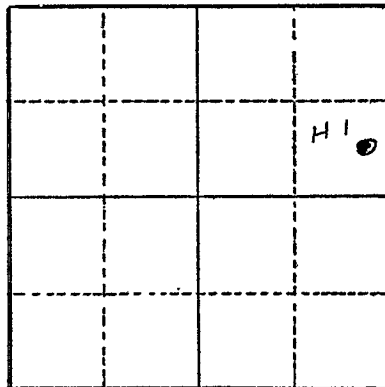

Section 27

Altitude at well 225 ft.

TYPE OF WELL: drilled Date Constructed Mar. '55

Depth drilled 108 ft. Depth cased 108 ft.

CASING RECORD: 8 inch

FINISH:

AQUIFERS:

WATER LEVEL: 90 ft.

PUMPING EQUIPMENT: Type Berkeley turbine H.P. 3
Capacity ? G.P.M.

WELL TESTS:
Drawdown ft. after hours G.P.M.
Drawdown ft. after hours G.P.M.

USE OF WATER irrigation Temp. °F., 19

SOURCE OF INFORMATION Ground Water Registration Record

DRILLER or DIGGER Stadeli & Son, Silverton, Oregon

ADDITIONAL DATA:
Log No Water Level Measurements Chemical Analysis Aquifer Test

REMARKS: