

STATE ENGINEER  
Salem, Oregon

# Well Record

Polk  
2176  
STATE WELL NO. 7/4W-35M  
COUNTY Polk  
APPLICATION NO. GR-1380

GR- 1337

OWNER: Walter H. Brown


MAILING ADDRESS: Rt. 1, Box 287

LOCATION OF WELL: Owner's No. #1

CITY AND STATE: Independence, Oregon

NW 1/4 SW 1/4 Sec. 35 T. 7 S., R. 4 W., W.M.

Bearing and distance from section or subdivision  
corner 2340' N. & 1120' E. from SW cor. Sec. 35

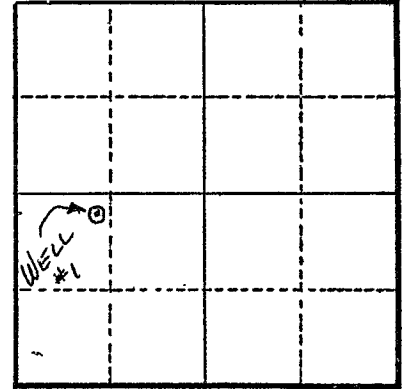

Section 35

Altitude at well

TYPE OF WELL: Drilled Date Constructed 1944

Depth drilled 21 ft. Depth cased 21 ft.

CASING RECORD:  
8 inch

FINISH:  
Perforated with 5/8 in. drill holes

AQUIFERS:

WATER LEVEL:  
4 ft.

PUMPING EQUIPMENT: Type Cent. H.P. 10  
Capacity 300 G.P.M.

WELL TESTS:  
Drawdown 16 ft. after 500 hours G.P.M.  
Drawdown ft. after hours G.P.M.

USE OF WATER Irrigation Temp. °F., 19

SOURCE OF INFORMATION G. R. Record

DRILLER or DIGGER Sloper

ADDITIONAL DATA:  
Log Water Level Measurements Chemical Analysis Aquifer Test

REMARKS:

Log: Heavy clay 0 to 7 ft.  
Sand & gravel 7 to 21 ft.

Irrigation of 51 acres.