


STATE ENGINEER
Salem, Oregon

Well Record Polk STATE WELL NO. 7/4W-35A(2)
COUNTY Marion Polk
2181 APPLICATION NO. GR-682

OWNER: Oregon State Hospital MAILING ADDRESS: Station A

LOCATION OF WELL: Owner's No. #2 CITY AND STATE: Salem, Oregon

NE ¼ NE ¼ Sec. 35 T. 7 S., R. 4 W., W.M.
Bearing and distance from section or subdivision
corner 352' S. & 376' W. of NE corner
section 35

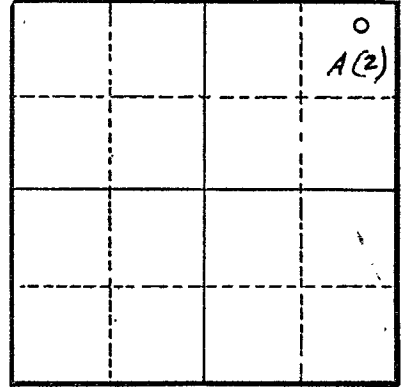

Section 35

Altitude at well 147.6 ft.

TYPE OF WELL: Drilled Date Constructed 1920
Depth drilled 50 ft. Depth cased 50 ft.

CASING RECORD:
12 in. from 0 to 50 ft.

FINISH:

AQUIFERS:

WATER LEVEL:
12 feet

PUMPING EQUIPMENT: Type Wisc. gas - Hale cent. H.P. 33
Capacity G.P.M.

WELL TESTS:
Drawdown ft. after hours G.P.M.
Drawdown ft. after hours G.P.M.

USE OF WATER Irrigation Temp. °F. , 19
SOURCE OF INFORMATION GR-682

DRILLER or DIGGER
ADDITIONAL DATA:
Log Water Level Measurements Chemical Analysis Aquifer Test

REMARKS: