

STATE ENGINEER
Salem, Oregon

Well Record **Polk** STATE WELL NO. **7/4W-35H(1)**
2185 COUNTY **Marion Polk**
APPLICATION NO. **GR-684**

OWNER: Oregon State Hospital


MAILING ADDRESS: Station A

LOCATION OF WELL: Owner's No. #1

CITY AND STATE: Salem, Oregon

SE 1/4 NE 1/4 Sec. 35 T. 7 N S., R. 4 E W., W.M.

Bearing and distance from section or subdivision corner 1528' S. & 296' W. of NE corner section 35

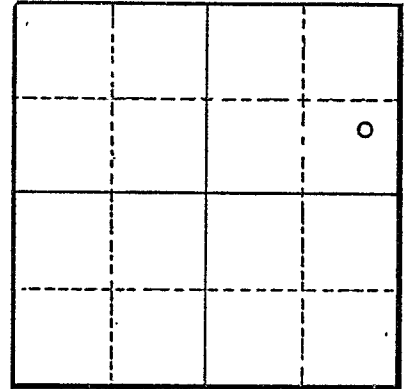

Section 35

Altitude at well 151.55 feet

TYPE OF WELL: Drilled Date Constructed 1920

Depth drilled 55 Ft. Depth cased 55 ft.

CASING RECORD:

12 in. from 0 to 55 feet

FINISH:

AQUIFERS:

WATER LEVEL:

15 feet

PUMPING EQUIPMENT: Type Wisc. gas - Hale cent. H.P. 33
Capacity _____ G.P.M.

WELL TESTS:

Drawdown _____ ft. after _____ hours _____ G.P.M.
Drawdown _____ ft. after _____ hours _____ G.P.M.

USE OF WATER Irrigation Temp. _____ °F. _____, 19____

SOURCE OF INFORMATION GR-684

DRILLER or DIGGER _____

ADDITIONAL DATA:

Log _____ Water Level Measurements _____ Chemical Analysis _____ Aquifer Test _____

REMARKS: