

STATE ENGINEER
Salem, Oregon


Well Record **Polk**
2187 STATE WELL NO. 7/LW-35L
COUNTY Polk
APPLICATION NO. GR-3110

OWNER: Gordon Walker for Dean Walker Farms MAILING ADDRESS: 168 C Street

LOCATION OF WELL: Owner's No. _____ CITY AND STATE: Independence, Oregon

NE $\frac{1}{4}$ SW $\frac{1}{4}$ Sec. 35 T. 7 N S., R. 4 E W., W.M.

Bearing and distance from section or subdivision corner 220 $\frac{1}{2}$ ' W. and 25' S. from NE Corner Bethuel
Dove Claim No. 5 $\frac{1}{2}$

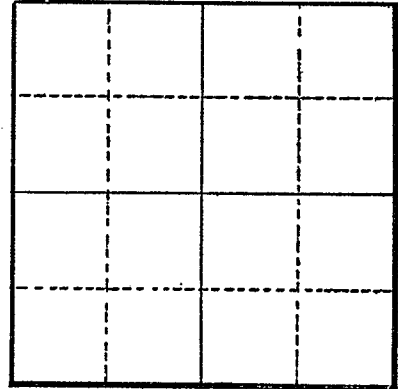

Section _____

Altitude at well _____

TYPE OF WELL: Drilled Date Constructed 1953

Depth drilled 40' Depth cased 40'

CASING RECORD:
12"

FINISH:

perforated 9 $\frac{1}{2}$ x 4 from 30 to 40

AQUIFERS:

WATER LEVEL:
22'

PUMPING EQUIPMENT: Type Pacific H.P. 30
Capacity 600 G.P.M.

WELL TESTS:
Drawdown 12' ft. after _____ hours pumping 550 G.P.M.
Drawdown _____ ft. after _____ hours _____ G.P.M.

USE OF WATER Irrigation Temp. _____ °F. _____, 19

SOURCE OF INFORMATION GR-2918

DRILLER or DIGGER Art Clinton, Independence, Oregon

ADDITIONAL DATA:

Log _____ Water Level Measurements _____ Chemical Analysis _____ Aquifer Test _____

REMARKS: