

STATE ENGINEER  
Salem, Oregon

# Well Record

STATE WELL NO. 8/4W-2J  
COUNTY Polk  
APPLICATION NO. GR-1515

GR-1463

Polk  
2788

OWNER: E. Clemens Horst Co.

MAILING ADDRESS: Rt. 1


LOCATION OF WELL: Owner's No. #6

CITY AND STATE: Independence, Oregon

NE 1/4 SE 1/4 Sec. 2 T. 8 S., R. 4 W., W.M.

XXXXXXXXXXXX

Bearing and distance from section or subdivision corner N. 54° E. 5340' from NW cor. Sec. 11

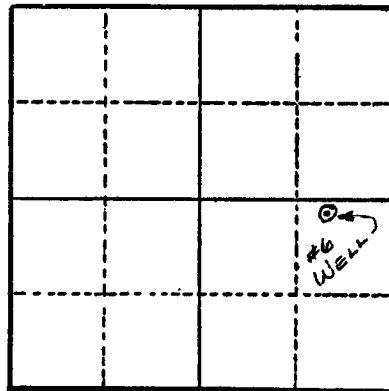

Section 2

Altitude at well

TYPE OF WELL: Drilled Date Constructed 1951

Depth drilled 40' Depth cased 40'

### CASING RECORD:

12"

### FINISH:

Torch cut perforations from 30 to 40 ft.

### AQUIFERS:

### WATER LEVEL:

25'

PUMPING EQUIPMENT: Type 2 1/2" Cent. H.P. 20

Capacity 400 G.P.M.

### WELL TESTS:

Drawdown 10 ft. after 300 hours G.P.M.

Drawdown ft. after hours G.P.M.

USE OF WATER Irrigation Temp. °F. 19

SOURCE OF INFORMATION GR Record

DRILLER or DIGGER

### ADDITIONAL DATA:

Log Water Level Measurements Chemical Analysis Aquifer Test

### REMARKS:

Log: Clay loam 0 to 15 ft.  
 Sandy loam 15 to 25 ft.  
 Gravel 25 to 40 ft.

Irrigation of 62.6 acres.