

STATE ENGINEER  
Salem, Oregon

Well Record **Polk** STATE WELL NO. 8/4W-2P  
COUNTY Polk  
GR- 1462 2789 APPLICATION NO. GR- 1514

OWNER: E. Clemens Horst Co. MAILING ADDRESS: Rt. 1

LOCATION OF WELL: Owner's No. #5 CITY AND STATE: Independence, Oregon


SE 1/4 SW 1/4 Sec. 2 T. 8 S, R. 4 W., W.M.

Bearing and distance from section or subdivision corner N. 57°30' E. 2470' from NW cor. Sec. 11

Altitude at well

TYPE OF WELL: Drilled Date Constructed 1910

Depth drilled 40' Depth cased 40'

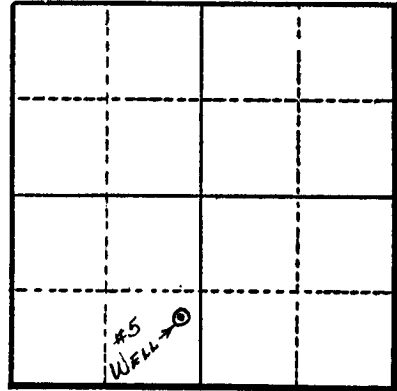

Section 2

CASING RECORD:

12"

FINISH:

AQUIFERS:

WATER LEVEL:

25'

PUMPING EQUIPMENT: Type 3" x 4" Cent. H.P. 25

Capacity 500 G.P.M.

WELL TESTS:

Drawdown 10 ft. after 500 hours G.P.M.

Drawdown ft. after hours G.P.M.

USE OF WATER Irrigation Temp. °F. 19

SOURCE OF INFORMATION GR Record

DRILLER or DIGGER

ADDITIONAL DATA:

Log Water Level Measurements Chemical Analysis Aquifer Test

REMARKS:

Log: Clay loam 0 to 15 ft.  
Sandy loam 15 to 25 ft.  
Gravel 25 to 40 ft.

Irrigation of 112.9 acres.