

STATE ENGINEER
Salem, Oregon


POK
2877

Well Record

STATE WELL NO. 8/4W-10H(1)
COUNTY Polk
APPLICATION NO. GR-351

OWNER: Pearl Ruddell MAILING ADDRESS: _____
CITY AND STATE: Independence, Oregon

LOCATION OF WELL: Owner's No. _____
SE 1/4 NE 1/4 Sec. 10 T. 8 S., R. 4 W., W.M.
Bearing and distance from section or subdivision
corner 575' N. & 1300' W. of E 1/4 Cor. Sec. 10

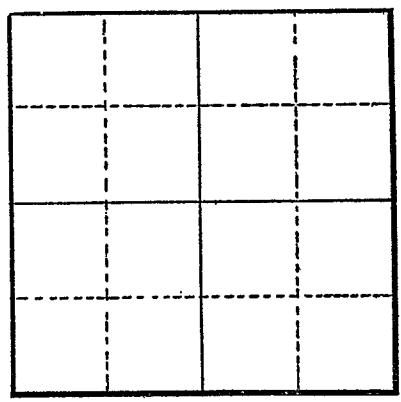

Section _____

Altitude at well 210 ft.

TYPE OF WELL: Dug&Drilled Date Constructed Aug. 7, "41"

Depth drilled 40 ft. Depth cased 40 ft.

CASING RECORD: 10 inch

FINISH: _____

AQUIFERS: _____

WATER LEVEL: 15 ft.

PUMPING EQUIPMENT: Type centrifugal H.P. 50
Capacity 1,000 G.P.M.

WELL TESTS:
Drawdown _____ ft. after _____ hours _____ G.P.M.
Drawdown _____ ft. after _____ hours _____ G.P.M.

USE OF WATER irrigation Temp. _____ °F., 19 _____

SOURCE OF INFORMATION Ground Water Registration Record
DRILLER or DIGGER W. A. Sloper (deceased) Independence, Oregon

ADDITIONAL DATA:
Log No Water Level Measurements _____ Chemical Analysis _____ Aquifer Test _____

REMARKS: Dug 10 ft.; Drilled to 40 ft.