

STATE ENGINEER
Salem, Oregon

Polk
2878 Well Record


STATE WELL NO. 8/LW-10J
COUNTY Polk
APPLICATION NO. GR-3132

OWNER: C. Parker Gies and Loeta J. Gies MAILING ADDRESS: Route 1, Box 264

LOCATION OF WELL: Owner's No. _____ CITY AND STATE: Independence, Oregon

NE 1/4 SE 1/4 Sec. 10 T. 8 S., R. 4 W., W.M.

Bearing and distance from section or subdivision corner 3311.5' W and 660.18' N. of SE Corner of Henry and Martha Hawkins Donation Land Claim No. 56

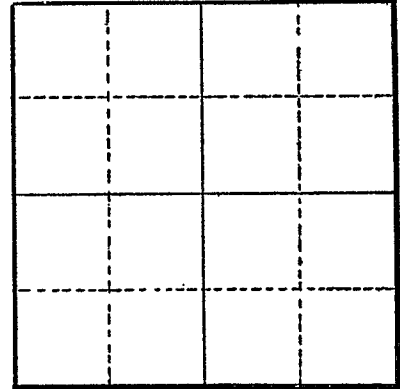

Section _____

Altitude at well _____

TYPE OF WELL: drilled Date Constructed 1944

Depth drilled 30' Depth cased 32'

CASING RECORD:

12"

FINISH:

1/2" X 2" slots- 20 to foot from 15' to 30'

AQUIFERS:

Soil, Sand and gravel

WATER LEVEL:

14'

PUMPING EQUIPMENT: Type 4" Gardner-Denver Rotary H.P. 100
Capacity 640 G.P.M.

WELL TESTS:

Drawdown 4 ft. after _____ hours pumping 624 G.P.M.
Drawdown _____ ft. after _____ hours _____ G.P.M.

USE OF WATER Irrigation Temp. _____ °F. _____, 19_____

SOURCE OF INFORMATION GR-2937

DRILLER or DIGGER Arch Sloper (deceased)

ADDITIONAL DATA:

Log x Water Level Measurements _____ Chemical Analysis _____ Aquifer Test _____

REMARKS:

top soil 3 3
sand 5 8
sand and gravel 22 30