

STATE ENGINEER
Salem, Oregon

Polk Well Record
2879 GR- 1461


STATE WELL NO. *8/4W-11C*
COUNTY *Polk*
APPLICATION NO. *GR-1513*

OWNER: *E. Clemens Horst Co.* MAILING ADDRESS: *Rt. 1*

LOCATION OF WELL: Owner's No. *#4* CITY AND STATE: *Independence, Oregon*

NE 1/4 *NW* 1/4 Sec. *11* T. *8* S., R. *4* W., W.M.

Bearing and distance from section or subdivision corner *S. 84° 30' E. 2190'* from NW cor. Sec. *11*

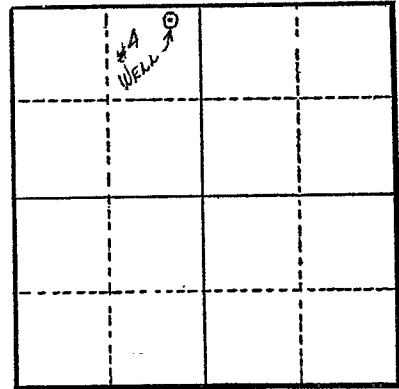

Section *11*

Altitude at well

TYPE OF WELL: *Drilled* Date Constructed *1953*

Depth drilled *40'* Depth cased *40'*

CASING RECORD:

12"

FINISH:

Torch cut perforations from 25 to 40 ft.

AQUIFERS:

WATER LEVEL:

25'

PUMPING EQUIPMENT: Type *4" x 5" Cent.* H.P. *30*
Capacity *300* G.P.M.

WELL TESTS:
Drawdown *10* ft. after *300* hours G.P.M.
Drawdown *10* ft. after *300* hours G.P.M.

USE OF WATER *Irrigation* Temp. *19* °F.

SOURCE OF INFORMATION *GR Record*

DRILLER or DIGGER

ADDITIONAL DATA:
Log *Water Level Measurements* *Chemical Analysis* *Aquifer Test*

REMARKS:

Log: Clay loam 0 to 15 ft.
Sandy loam 15 to 25 ft.
Gravel 25 to 40 ft.

Irrigation of 42.7 acres.