

STATE ENGINEER
Salem, Oregon

POK
2880 Well Record

STATE WELL NO. *8/W-11D*
COUNTY *Polk*
APPLICATION NO. *GR-1512*

GR- 1460

OWNER: *E. Clemens Horst Co.*


MAILING ADDRESS: *Rt. 1*

LOCATION OF WELL: Owner's No. *#3*

CITY AND STATE: *Independence, Oregon*

NW 1/4 *NW* 1/4 Sec. *11* T. *8* S., R. *4* W., W.M.

Bearing and distance from section or subdivision corner *S.37°E. 1070'* from NW cor. Sec. *11*

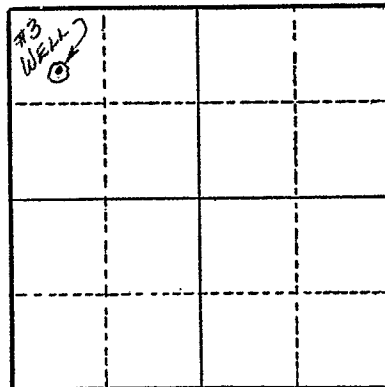

Section *11*

Altitude at well

TYPE OF WELL: *Drilled* Date Constructed *1910*

Depth drilled *50'* Depth cased *50'*

CASING RECORD:

8"

FINISH:

AQUIFERS:

WATER LEVEL:

20'

PUMPING EQUIPMENT: Type *5" x 6" Cent.* H.P. *40*
Capacity *800* G.P.M.

WELL TESTS:

Drawdown *10* ft. after *800* hours G.P.M.
Drawdown ft. after hours G.P.M.

USE OF WATER *Irrigation* Temp. °F. *19*

SOURCE OF INFORMATION *GR Record*

DRILLER or DIGGER

ADDITIONAL DATA:

Log Water Level Measurements Chemical Analysis Aquifer Test

REMARKS:

Log: Silt loam 0 to 15 ft.
Clay loam 15 to 25 ft.
Gravel 25 to 40 ft.

Irrigation of *135.5* acres.