

STATE ENGINEER
Salem, Oregon


Polk
2881 Well Record

STATE WELL NO. *8/LW-11K(1)*
COUNTY *Polk*
APPLICATION NO. *GR-1110*

GR- 1070

OWNER: *John I. Haas, Inc. of Baltimore, Md.* Mailing ADDRESS: *Rt. 1, Box 3*
Mitoma Farm CITY AND STATE: *Independence, Oregon*

LOCATION OF WELL: Owner's No. _____
NW 1/4 SE 1/4 Sec. 11 T. 8 S., R. 4 W., W.M.
Bearing and distance from section or subdivision
corner *2100' N. & 2000' W. from SE cor. Sec. 11.*

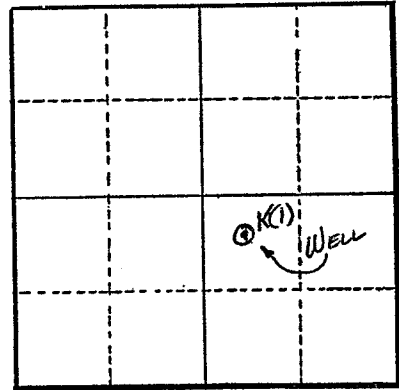

Section *11*

Altitude at well *150 ft.*

TYPE OF WELL: *Drilled* Date Constructed *1950*

Depth drilled *42 ft.* Depth cased *42 ft.*

CASING RECORD:

12 inch

FINISH:

Perforated - 12 per ft. slots 1/2" x 8" from 26 to 42 ft.

AQUIFERS:

WATER LEVEL:

19 ft.

PUMPING EQUIPMENT: Type *Pacific 3 x 4 in.* H.P. *40*
Capacity *900* G.P.M.

WELL TESTS:

Drawdown *6* ft. after _____ hours *900* G.P.M.
Drawdown _____ ft. after _____ hours _____ G.P.M.

USE OF WATER *Irrigation* Temp. _____ °F. _____, 19

SOURCE OF INFORMATION *G. R. Record*

DRILLER or DIGGER _____

ADDITIONAL DATA:

Log _____ Water Level Measurements _____ Chemical Analysis _____ Aquifer Test _____

REMARKS:

Log: *River bottom top soil* *0 to 18 ft.*
Sand & gravel *18 to 42 ft.*

Irrigation of 11.7 acres.