

STATE ENGINEER
Salem, Oregon

Polk
2882 Well Record
GR- 1458


STATE WELL NO. 8/4W-111
COUNTY Polk
APPLICATION NO. GR- 1510

OWNER: E. Clemens Horst Co. MAILING ADDRESS: Rt. 1

LOCATION OF WELL: Owner's No. #1 CITY AND STATE: Independence, Oregon

NE 1/4 SW 1/4 Sec. 11 T. 8 S., R. 4 W., W.M.

Bearing and distance from section or subdivision corner S19°E. 4170' from NW cor. Sec. 11

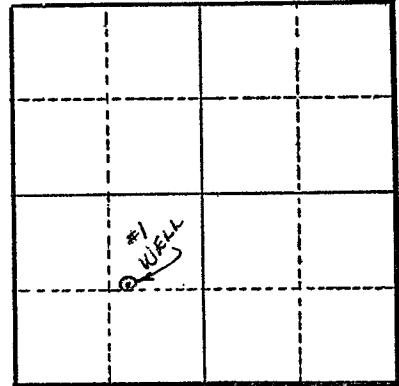

Section 11

Altitude at well

TYPE OF WELL: Drilled Date Constructed 1943

Depth drilled 40' Depth cased 30'

CASING RECORD:

10" pitted well from 1' to 30'

FINISH:

Torch cut perforations from 30' to 40' ???

AQUIFERS:

WATER LEVEL:

20'

PUMPING EQUIPMENT: Type 3" x 4" Cent. H.P. 15
Capacity 400 G.P.M.

WELL TESTS:

Drawdown 8 ft. after 400 hours G.P.M.
Drawdown ft. after hours G.P.M.

USE OF WATER Irrigation Temp. °F. 19

SOURCE OF INFORMATION GR Record

DRILLER or DIGGER

ADDITIONAL DATA:

Log Water Level Measurements Chemical Analysis Aquifer Test

REMARKS:

Log: Silt loam 0 to 15 ft.
Clay loam 15 to 25 ft.
Gravel 25 to 40 ft.

Irrigation of 54.1 acres.