

STATE ENGINEER
Salem, Oregon

Well Record *Polk* STATE WELL NO. 8/LW-16P(1)
COUNTY Polk
2906 APPLICATION NO. GR-268

OWNER: Dean Walker Farms MAILING ADDRESS: _____

LOCATION OF WELL: Owner's No. 1 CITY AND STATE: Independence, Oregon


SE 1/4 SW 1/4 Sec. 16 T. 8 S., R. 4 W., W.M.

Bearing and distance from section or subdivision corner S.81°52'W. 63.6 ch. from NE cor. of the T. L. Burbank DLC.

Altitude at well 1140'

TYPE OF WELL: Drilled Date Constructed 6/20/51

Depth drilled 55' Depth cased 55'

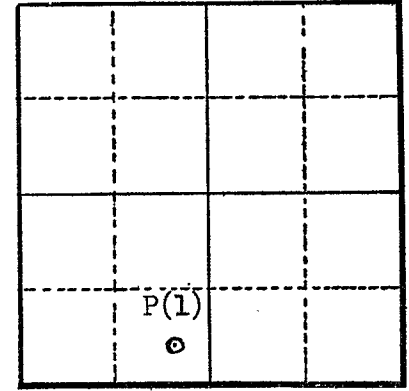

Section 16

CASING RECORD:
12 inch

FINISH:
9 slots (1/2"x4") set from 45 to 55 feet

AQUIFERS:

WATER LEVEL:
20 feet

PUMPING EQUIPMENT: Type Jacuzzi 6" turbine H.P. 30
Capacity 650 G.P.M.

WELL TESTS:
Drawdown 30 ft. after _____ hours 650 G.P.M.
Drawdown _____ ft. after _____ hours _____ G.P.M.

USE OF WATER Irrigation (37 1/2 acres) Temp. _____ °F. _____, 19____

SOURCE OF INFORMATION GR-247
DRILLER or DIGGER Art Clinton, Independence

ADDITIONAL DATA:
Log NA Water Level Measurements _____ Chemical Analysis _____ Aquifer Test _____

REMARKS: