

Polk  
2007

OWNER: Dean Walker Farms

MAILING ADDRESS:


LOCATION OF WELL: Owner's No. 3

CITY AND STATE:

Independence, Oregon

SE 1/4 SE 1/4 Sec. 16 T. 8 S., R. 4 W., W.M.

Bearing and distance from section or subdivision corner S.86°59'W. 18.43 ch. from NE Cor. of the T.L. Burbank DLC.

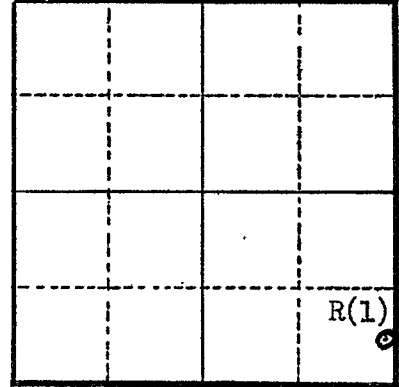

Section 16

Altitude at well 145'

TYPE OF WELL: Drilled Date Constructed 6/15/49

Depth drilled 45' Depth cased 33'

CASING RECORD:

Pit - 6' x 8' x 12' deep  
12 inch casing from 12 to 45 feet

FINISH:

Slots - 9 (1/2"x1") set from 35 to 45 feet

AQUIFERS:

WATER LEVEL:

25 feet

PUMPING EQUIPMENT: Type Goulds centrifugal 3"x4" H.P. 20  
Capacity 500 G.P.M.

WELL TESTS:

Drawdown 14 ft. after 500 hours G.P.M.  
Drawdown ft. after hours G.P.M.

USE OF WATER Irrigation (52.8 acres) Temp. °F., 19

SOURCE OF INFORMATION GR- 247

DRILLER or DIGGER Art Clinton, Independence

ADDITIONAL DATA:

Log NA Water Level Measurements Chemical Analysis Aquifer Test

REMARKS: