

STATE ENGINEER  
Salem, Oregon

*Polk*  
*2927*

# Well Record

STATE WELL NO. 8/4W-19R  
COUNTY POLK  
APPLICATION NO. GR-2868

OWNER: Fred F. Noyes


MAILING ADDRESS: Rt. 1, Box 112 A.

LOCATION OF WELL: Owner's No. \_\_\_\_\_

CITY AND STATE: Monmouth, Oregon

SE 1/4 SE 1/4 Sec. 19 T. 8 S. R. 4 W., W.M.

Bearing and distance from section or subdivision  
corner 66.05 ch. W. and 1154' N. from SE corner  
J. Carmack D.L.C. 66.

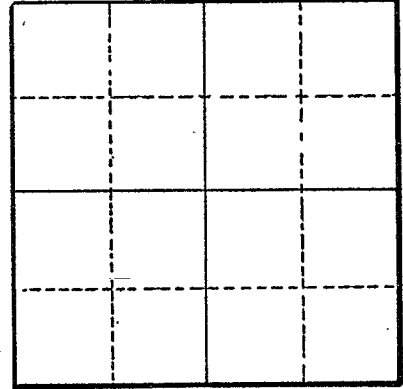

Section \_\_\_\_\_

Altitude at well \_\_\_\_\_

TYPE OF WELL: Drilled Date Constructed 1950

Depth drilled 40 Depth cased 40

### CASING RECORD:

8-inch

### FINISH:

1/4" x 6" Torch/cut Perforations from 25' to 35'

### AQUIFERS:

Topsoil, clay, sand and gravel

### WATER LEVEL:

PUMPING EQUIPMENT: Type Jet H.P. 7 1/2  
Capacity 60 G.P.M.

### WELL TESTS:

Drawdown \_\_\_\_\_ ft. after \_\_\_\_\_ hours \_\_\_\_\_ G.P.M.  
Drawdown \_\_\_\_\_ ft. after \_\_\_\_\_ hours \_\_\_\_\_ G.P.M.

USE OF WATER Irrigation Temp. \_\_\_\_\_ °F. \_\_\_\_\_, 19\_\_\_\_\_

SOURCE OF INFORMATION GR-2702

DRILLER or DIGGER \_\_\_\_\_

### ADDITIONAL DATA:

Log X Water Level Measurements \_\_\_\_\_ Chemical Analysis \_\_\_\_\_ Aquifer Test \_\_\_\_\_

### REMARKS:

Topsoil 0'-2' 2'  
Brown clay 2'-20' 18'  
Sand & Gravel (water bearing) 20'-35' 15'  
Blue Clay 35'-40' 5'