

STATE ENGINEER
Salem, Oregon

Well Record

STATE WELL NO. 8/4W-21B(1)
COUNTY Polk
APPLICATION NO. GR-268

Polk
2941


OWNER: Dean Walker Farms

MAILING ADDRESS: _____

LOCATION OF WELL: Owner's No. 2

CITY AND STATE: Independence, Oregon

NW $\frac{1}{4}$ NE $\frac{1}{4}$ Sec. 21 T. 8 S., R. 4 W., W.M.

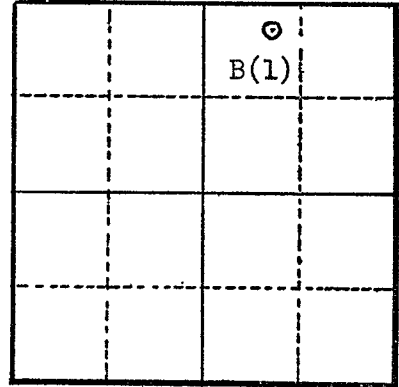

Bearing and distance from section or subdivision corner S.69°18'W. 44.1 ch. from NE cor. of the T. L. Burbank DIC.

Altitude at well 140'

TYPE OF WELL: Drilled Date Constructed 12/14/54

Depth drilled 55' Depth cased 55'

Section 21

CASING RECORD:
12 inch

FINISH: _____

AQUIFERS:

Gravel from 20 to 55 feet

WATER LEVEL:

17 feet

PUMPING EQUIPMENT: Type Jacuzzi, 6 stage turbine H.P. 30
Capacity 650 G.P.M.

WELL TESTS:

Drawdown 14 ft. after _____ hours 700 G.P.M.

Drawdown _____ ft. after _____ hours _____ G.P.M.

USE OF WATER Irrigation (52.8 acres) Temp. _____ °F., 19

SOURCE OF INFORMATION GR-247

DRILLER or DIGGER _____

ADDITIONAL DATA:

Log Water Level Measurements _____ Chemical Analysis _____ Aquifer Test _____

REMARKS: _____

