

STATE ENGINEER
Salem, Oregon

Polk Well Record
2014


STATE WELL NO. 8/LW-219(1)
COUNTY Polk
APPLICATION NO. GR-422

OWNER: Francis R. Holt MAILING ADDRESS: 388 C. St.

LOCATION OF WELL: Owner's No. _____ CITY AND STATE: Independence, Oregon

SW $\frac{1}{4}$ NE $\frac{1}{4}$ Sec. 21 T. 8 S., R. 4 W., W.M.

Bearing and distance from section or subdivision corner 410' E. & 375' N. of interior cor. of the C. P. Cook DIC #63.

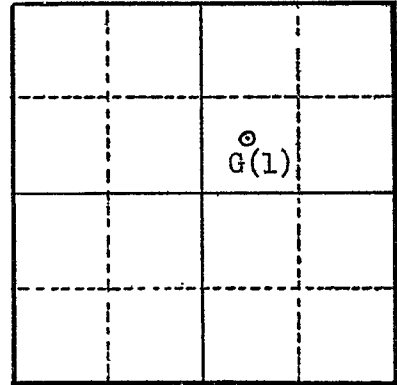

Section 21

Altitude at well 145'

TYPE OF WELL: Drilled Date Constructed 6/8/52

Depth drilled 42' Depth cased _____

CASING RECORD:
12 inch

FINISH:

AQUIFERS:

WATER LEVEL:
4 feet

PUMPING EQUIPMENT: Type F. M., centrifugal H.P. 20
Capacity 1000 G.P.M.

WELL TESTS:
Drawdown _____ ft. after _____ hours _____ G.P.M.
Drawdown _____ ft. after _____ hours _____ G.P.M.

USE OF WATER Irrigation (75 acres) Temp. _____ °F., 19

SOURCE OF INFORMATION GR-408

DRILLER or DIGGER Art Clinton, Independence

ADDITIONAL DATA:
Log NA Water Level Measurements _____ Chemical Analysis _____ Aquifer Test _____

REMARKS: