

STATE ENGINEER
Salem, Oregon

Well Record

Polk
2952 STATE WELL NO. 8/W-22A(1)
COUNTY Polk
APPLICATION NO. GR- 268

OWNER: Dean Walker Farms


MAILING ADDRESS: _____

LOCATION OF WELL: Owner's No. 6

CITY AND STATE: Independence, Oregon

NE $\frac{1}{4}$ NE $\frac{1}{4}$ Sec. 22 T. _____ N. _____ E. _____
S., R. _____ W., W.M.

Bearing and distance from section or subdivision
corner S.70°17'E. 57.22 ch. from NE cor. of the
T. L. Burbank DIC.

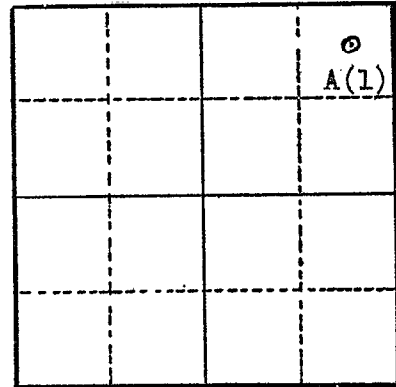

Altitude at well 140'

Section 22

TYPE OF WELL: Drilled Date Constructed 5/2/49

Depth drilled 30' Depth cased 30'

CASING RECORD:
12 inch

FINISH: 9 slots ($\frac{1}{2}$ "x4") set from 20 to 30 feet

AQUIFERS:

WATER LEVEL:
5 feet

PUMPING EQUIPMENT: Type Goulds, 3"x4" centrifugal H.P. 30
Capacity 700 G.P.M.

WELL TESTS:
Drawdown 10 ft. after _____ hours 1000 G.P.M.
Drawdown _____ ft. after _____ hours _____ G.P.M.

USE OF WATER Irrigation (115.9 acres) Temp. _____ °F. _____, 19____

SOURCE OF INFORMATION GR- 247

DRILLER or DIGGER Art Clinton, Independence

ADDITIONAL DATA:
Log NA Water Level Measurements _____ Chemical Analysis _____ Aquifer Test _____

REMARKS: