

STATE ENGINEER  
Salem, Oregon


Well Record *Polk* STATE WELL NO. 8/LW-22B(1)  
*2953* COUNTY Polk  
APPLICATION NO. GR- 268

OWNER: Dean Walker Farms MAILING ADDRESS:

LOCATION OF WELL: Owner's No. 5 CITY AND STATE: Independence, Oregon

NW 1/4 NE 1/4 Sec. 22 T. 8 S., R. 4 W., W.M.

Bearing and distance from section or subdivision corner S.47°10'E, 39.86 ch. from NE cor. of the T. L. Burbank DIC.

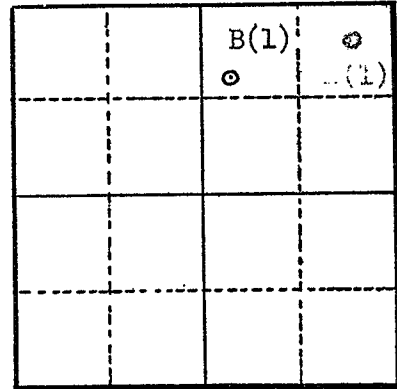

Section 22

Altitude at well 150'

TYPE OF WELL: Drilled Date Constructed 5/15/50

Depth drilled 55' Depth cased 55'

CASING RECORD:  
12 inch

FINISH: 9 slots (1/2"x4") set from 45 to 55 feet

AQUIFERS:

WATER LEVEL:  
25 feet

PUMPING EQUIPMENT: Type F. M. turbine H.P. 50  
Capacity 1000 G.P.M.

WELL TESTS:  
Drawdown 25 ft. after hours 1000 G.P.M.  
Drawdown ft. after hours G.P.M.

USE OF WATER Irrigation (107.9 acres) Temp. °F., 19

SOURCE OF INFORMATION GR- 247

DRILLER or DIGGER Art Clinton, Independence

ADDITIONAL DATA:  
Log NA Water Level Measurements Chemical Analysis Aquifer Test

REMARKS: