

STATE ENGINEER
Salem, Oregon

Well Record

STATE WELL NO. 8/LW-28L
COUNTY Polk
APPLICATION NO. GR-3183


OWNER: Pacific Power & Light Co.

MAILING ADDRESS: Public Service Building

LOCATION OF WELL: Owner's No. Well #1

CITY AND STATE: Portland 4, Oregon

NE 1/4 SW 1/4 Sec. 28 T. 8 ~~N.~~ 4 ~~E.~~ W., W.M.

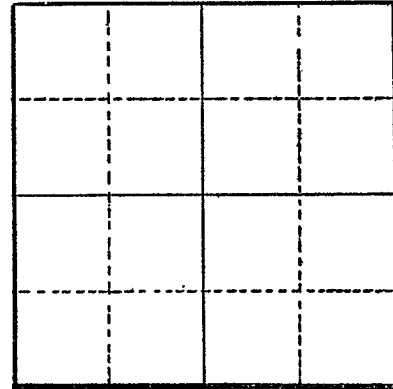

Section

Bearing and distance from section or subdivision corner S.12°31' W. 804.00' from intersection of South Line of "I" Street and East Line SP RR right of way Block 19, Hill's Addition to Hill's Independence.

Altitude at well

TYPE OF WELL: drilled Date Constructed 1951

Depth drilled 71.5" Depth cased 71.5'

CASING RECORD:

12"

FINISH:

6 rows 1/2" x 12" from 30 to 68

AQUIFERS:

topsoil, clay, gravel

WATER LEVEL:

45'

PUMPING EQUIPMENT: Type Pomona Turbine 7 MC H.P. 10

Capacity 250 G.P.M.

WELL TESTS:

Drawdown 8 ft. after hours pumping 244 G.P.M.

Drawdown 20 ft. after hours pumping 472 G.P.M.

USE OF WATER Municipal Temp. °F., 19.....

SOURCE OF INFORMATION GR-3141

DRILLER or DIGGER Art Clinton, Route 1, Box 2, Independence, Oregon

ADDITIONAL DATA:

Log Water Level Measurements Chemical Analysis Aquifer Test

REMARKS:

0-2 topsoil 2
2-30 Brown clay 28
30-70 Sand and gravel 40
70-71.5 Blue Clay 1.5