

STATE ENGINEER
Salem, Oregon


Polk
2975 Well Record

STATE WELL NO. 8/LW-28
COUNTY Polk
APPLICATION NO. GR-3185

OWNER: Pacific Power & Light Co. MAILING ADDRESS: Public Service Building
LOCATION OF WELL: Owner's No. Well #3 CITY AND STATE: Portland 1, Oregon

SW 1/4 1/4 Sec. 28 T. 8 N. S., R. 4 E. W., W.M.

Bearing and distance from section or subdivision corner S. 12°30' W. 804.00' from intersection of South line of "I" Street and East line SP RR right of way, Block 19, Hill's Addition to Hill's Independence.

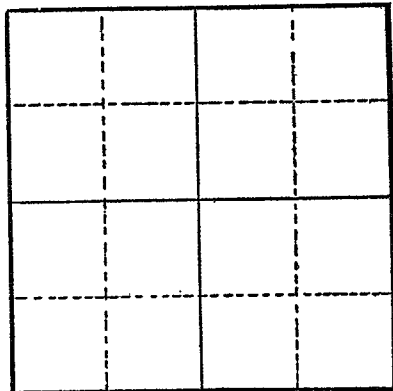

Section

Altitude at well

TYPE OF WELL: drilled Date Constructed 1953

Depth drilled 84' Depth cased 84'

CASING RECORD:

12"

FINISH:

6 rows 1/2" x 12" from 30 to 74

AQUIFERS:

topsoil, brown clay, sand and gravel

WATER LEVEL:

45'

PUMPING EQUIPMENT: Type Fairbanks Morse H.P. 15
Capacity 400 G.P.M.

WELL TESTS:
Drawdown 15 ft. after hours pumping 300 G.P.M.
Drawdown ft. after hours G.P.M.

USE OF WATER Municipal Temp. °F. 19

SOURCE OF INFORMATION GR-3143
DRILLER or DIGGER Art Clinton, Independence, Oregon

ADDITIONAL DATA:
Log x Water Level Measurements Chemical Analysis Aquifer Test

REMARKS:

0-2 Topsoil 2
2-30 Brown clay 28
30-80 Sand and gravel 50