

STATE ENGINEER
Salem, Oregon

Polk
2976 Well Record


STATE WELL NO. 8/14W-28L
COUNTY Polk
APPLICATION NO. GR-3184

OWNER: Pacific Power & Light Co. MAILING ADDRESS: Public Service Building

LOCATION OF WELL: Owner's No. Well #2 CITY AND STATE: Portland 4, Oregon

NE 1/4 SW 1/4 Sec. 28 T. 8 N. S., R. 4 E. W., W.M.

Bearing and distance from section or subdivision corner S. 12°30' W. 804.00' from intersection of South line of "I" Street and East line SP RR right of way, Block 19, Hill's Addition to Hill's Independence

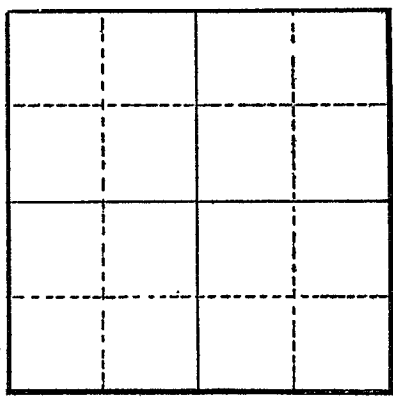

Section

Altitude at well

TYPE OF WELL: drilled Date Constructed 1951

Depth drilled 78' Depth cased 78'

CASING RECORD:
12"

FINISH:
6 rows 1/2" x 12"

AQUIFERS:
top soil, clay sand and gravel

WATER LEVEL:
45'

PUMPING EQUIPMENT: Type Pomona turbine 3 stage 8" H.P. 15
Capacity 400 G.P.M.

WELL TESTS:
Drawdown 15 ft. after hours pumping 320 G.P.M.
Drawdown ft. after hours G.P.M.

USE OF WATER Municipal Temp. °F., 19

SOURCE OF INFORMATION GR-3142
DRILLER or DIGGER Art. Clinton, Route 1, Box 2, Independence, Oregon

ADDITIONAL DATA:
Log X Water Level Measurements Chemical Analysis Aquifer Test

REMARKS:
0-2 topsoil 2
2-30 Brown clay 28
30-70 Sand and gravel 40
70-100 Blue clay 30