

STATE ENGINEER
Salem, Oregon

Polk
2977 Well Record
GR- 1455

STATE WELL NO. *8/4N-28N*
COUNTY *Polk*
APPLICATION NO. *GR-1507*

OWNER: *Donald Lee King*


MAILING ADDRESS: *951 7th St.*

LOCATION OF WELL: Owner's No. *#1*

CITY AND STATE: *Independence, Oregon*

SW 1/4 *SW* 1/4 Sec. *28* T. *8* S., R. *4* W., W.M.

Bearing and distance from section or subdivision corner *N.7°E. 720' from SW cor. Sec. 28*

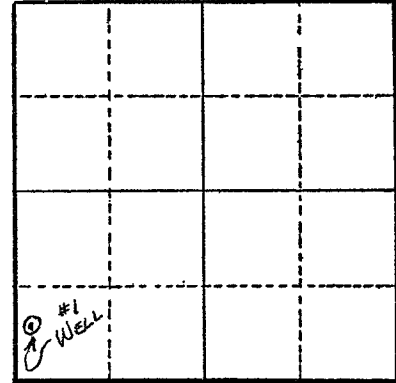

Section *28*

Altitude at well

TYPE OF WELL: *Drilled* Date Constructed *1951*

Depth drilled *64'* Depth cased *64'*

CASING RECORD:

12"

FINISH:

Torch cut perforations 3/ft. from 36' to 64'

AQUIFERS:

WATER LEVEL:

18'

PUMPING EQUIPMENT: Type *Berkeley turbine* H.P. *7 1/2*

Capacity *300* G.P.M.

WELL TESTS:

Drawdown *38* ft. after *450* hours G.P.M.

Drawdown _____ ft. after _____ hours G.P.M.

USE OF WATER *Irrigation* Temp. _____ °F. _____, 19

SOURCE OF INFORMATION *GR Record*

DRILLER or DIGGER *Art. Clinton*

ADDITIONAL DATA:

Log *N.A.* Water Level Measurements _____ Chemical Analysis _____ Aquifer Test _____

REMARKS:

Irrigation of 35.9 acres.

Sp capacity 22.5 gal/ft.