

STATE ENGINEER
Salem, Oregon

Well Record

Polk
STATE WELL NO. *8/4W-29J(1)*
COUNTY *Polk*
APPLICATION NO. *GR-1267*

GR- 1223

OWNER: Kenneth Oberson


MAILING ADDRESS: Box 165

LOCATION OF WELL: Owner's No. #1

CITY AND STATE: Independence, Oregon

NE 1/4 SE 1/4 Sec. 29 T. 8 S., R. 4 W., W.M.

Bearing and distance from section or subdivision corner N35°W. 1800' from SE cor. Sec. 29.

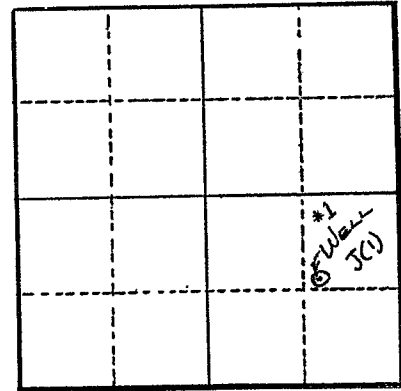

Section 29

Altitude at well _____

TYPE OF WELL: Drilled Date Constructed 1948

Depth drilled 59 ft. Depth cased 59 ft.

CASING RECORD:

12 inch

FINISH:

AQUIFERS:

WATER LEVEL:

20 ft.

PUMPING EQUIPMENT: Type Jacuzzi 3 in. jet H.P. 7 1/2

Capacity 100 G.P.M.

WELL TESTS:

Drawdown 38 ft. after _____ hours 100 G.P.M.

Drawdown _____ ft. after _____ hours _____ G.P.M.

USE OF WATER Irrigation Temp. _____ °F. _____, 19____

SOURCE OF INFORMATION G. R. Record

DRILLER or DIGGER Art Clinton

ADDITIONAL DATA:

Log N.A. Water Level Measurements _____ Chemical Analysis _____ Aquifer Test _____

REMARKS:

Irrigation of 27.6 acres.