

STATE ENGINEER
Salem, Oregon

Well Record *Polk* STATE WELL NO. 8/4W-29R(2)
COUNTY *Polk*

GR- 1222

JEM APPLICATION NO. GR- 1266

OWNER: *Kenneth Oberson*


MAILING ADDRESS: *Box 165*

LOCATION OF WELL: Owner's No. *#2*

CITY AND STATE: *Independence, Oregon*

XX XX
SE 1/4 SE 1/4 Sec. 29 T. 8 S., R. 4 W., W.M.

Bearing and distance from section or subdivision
corner *N48°W. 1400' from SE cor. Sec. 29.*

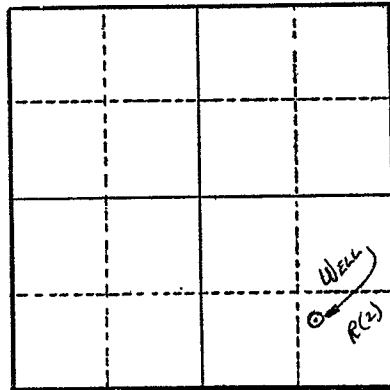

Section *29*

Altitude at well *160 ft.*

TYPE OF WELL: *Drilled* Date Constructed *1950*

Depth drilled *61 ft.* Depth cased *61 ft.*

CASING RECORD:

10 inch

FINISH:

Perforated with torch cut slots from 10 to 61 ft.

AQUIFERS:

WATER LEVEL:

20 ft.

PUMPING EQUIPMENT: Type *3 in. turbine* H.P. *5*

Capacity *200* G.P.M.

WELL TESTS:

Drawdown _____ ft. after _____ hours _____ G.P.M.

Drawdown _____ ft. after _____ hours _____ G.P.M.

USE OF WATER *Irrigation* Temp. _____ °F. _____, 19

SOURCE OF INFORMATION *G. R. Record*

DRILLER or DIGGER *Fred Wymore*

ADDITIONAL DATA:

Log *N. A.* Water Level Measurements _____ Chemical Analysis _____ Aquifer Test _____

REMARKS:

This well caved in and another was drilled 100 ft. straight South of it. (See log of same)