

STATE ENGINEER
Salem, Oregon

Well Record *Polk*
STATE WELL NO. *8/LW-29L(1)*
COUNTY *Polk*
APPLICATION NO. *GR-313*

OWNER: *J. C. Neill*
MAILING ADDRESS: *908 Church St.*
CITY AND STATE: *Dallas, Oregon*

LOCATION OF WELL: Owner's No. *1*


NE 1/4 *SW* 1/4 Sec. *29* T. *8* S., R. *4* W., W.M.

Bearing and distance from section or subdivision corner *3520' N. 43° W. to SW cor. of sec. 29* ????

(12/27/56) Approx. *160'* S. & *600'* W. from center of sec. *29*

Altitude at well *150'*

TYPE OF WELL: *Drilled* Date Constructed *Mar. 1948*
Depth drilled *68'* Depth cased *68'*

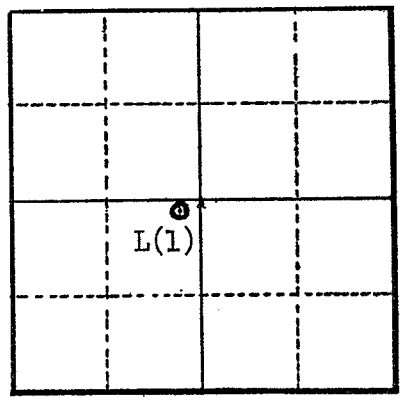

Section *29*

CASING RECORD:
11 inch ?

FINISH:
20 perforations (1/2"x10") set per foot from 47 to 68 feet

AQUIFERS:
Gravel from 50 to 68 feet

WATER LEVEL:
25 feet

PUMPING EQUIPMENT: Type *Jacuzzi, 4 inch jet* H.P. *7 1/2*
Capacity *200* G.P.M.

WELL TESTS:
Drawdown *5* ft. after _____ hours *112* G.P.M.
Drawdown _____ ft. after _____ hours _____ G.P.M.

USE OF WATER *Irrigation (16 acres)* Temp. _____ °F. _____, 19____

SOURCE OF INFORMATION *GR-294*

DRILLER or DIGGER _____

ADDITIONAL DATA:
Log *X* Water Level Measurements _____ Chemical Analysis _____ Aquifer Test _____

REMARKS:
Loam, silt clay 0 to 20
Clay, blue 20 to 50
Gravel 50 to 68