

STATE ENGINEER  
Salem, Oregon

# Well Record

*Polk*  
*3040*

STATE WELL NO. 8/4W-33L(1)  
COUNTY Polk  
APPLICATION NO. GR-1051

GR- 1013

OWNER: Harry Benzelman


MAILING ADDRESS: Rt. 1, Box 15 A

LOCATION OF WELL: Owner's No. \_\_\_\_\_

CITY AND STATE: Independence, Oregon

NE 1/4 SW 1/4 Sec. 33 T. 8 S., R. 4 W., W.M.

Bearing and distance from section or subdivision corner 3080' W. & 1550' N. of SE cor. Sec. 33.

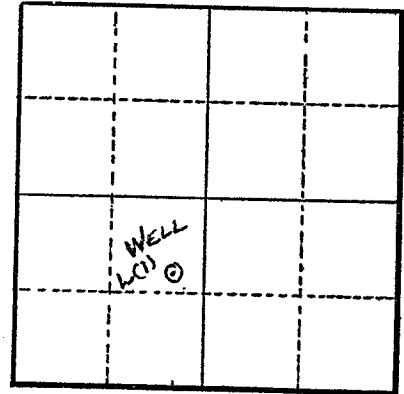

Section 33

Altitude at well 172 ft.

TYPE OF WELL: Drilled Date Constructed 1947

Depth drilled 50 ft. Depth cased 50 ft.

CASING RECORD:

10 inch

FINISH:

Perforated - 1" x 1 1/4" (18 to the foot) from 30 to 50 ft.

AQUIFERS:

WATER LEVEL:

20 ft.

PUMPING EQUIPMENT: Type Cook Cent.

H.P. 5

Capacity 150 G.P.M.

WELL TESTS:

Drawdown \_\_\_\_\_ ft. after \_\_\_\_\_ hours \_\_\_\_\_ G.P.M.

Drawdown \_\_\_\_\_ ft. after \_\_\_\_\_ hours \_\_\_\_\_ G.P.M.

USE OF WATER Irrigation Temp. \_\_\_\_\_ °F., 19.

SOURCE OF INFORMATION G.R. Record

DRILLER or DIGGER Art. Clinton

ADDITIONAL DATA:

Log N.A. Water Level Measurements \_\_\_\_\_ Chemical Analysis \_\_\_\_\_ Aquifer Test \_\_\_\_\_

REMARKS:

Irrigation of 12 acres.