

STATE ENGINEER
Salem, Oregon

Well Record *Polk* STATE WELL NO. *8/4W-330*
COUNTY *Polk*
GR- 1464 *3043* APPLICATION NO. GR- 1516

OWNER: *D. F. Kennedy*

MAILING ADDRESS: *Rt. 1*


LOCATION OF WELL: Owner's No. _____

CITY AND STATE: *Independence, Oregon*

SW 1/4 *SE* 1/4 Sec. *33* T. *8* S., R. *4* W., W.M.

Bearing and distance from section or subdivision

corner *S. 38° W. 1020'* from *NE* cor. *B.F. Burch DIC.*

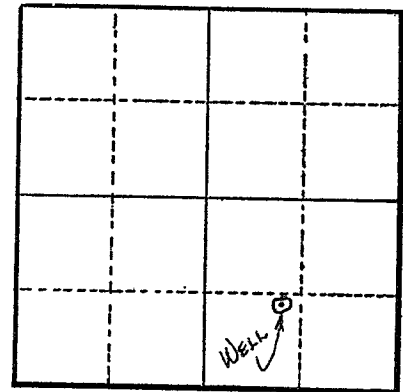

Section *33*

Altitude at well _____

TYPE OF WELL: *Drilled* Date Constructed *1948*

Depth drilled *40'* Depth cased *40'*

CASING RECORD:

12"

FINISH:

Torch cut perforations from 30 to 40 ft.

AQUIFERS:

WATER LEVEL:

16'

PUMPING EQUIPMENT: Type *Continental* *3" x 4" Cent.* H.P. *25*
Capacity *500* G.P.M.

WELL TESTS:

Drawdown *10* ft. after _____ hours *400* G.P.M.

Drawdown _____ ft. after _____ hours _____ G.P.M.

USE OF WATER *Irrigation* Temp. _____ °F. *19*

SOURCE OF INFORMATION *GR Record*

DRILLER or DIGGER *Arch Sloper*

ADDITIONAL DATA:

Log _____ Water Level Measurements _____ Chemical Analysis _____ Aquifer Test _____

REMARKS:

Log: Clay loam 0 to 12 ft.
Sand & gravel 12 to 40 ft.

Irrigation of *24.9* acres