

STATE ENGINEER
Salem, Oregon

Well Record *Polk*

STATE WELL NO. *8/4W-34H(1)*

COUNTY *Polk*

GR- 1067 *3047* APPLICATION NO. GR- 1107


OWNER: *R.L. Hardman dba Sunset Farms* MAILING ADDRESS: *Rt. 1, Box 265*

LOCATION OF WELL: Owner's No. CITY AND STATE: *Independence, Oregon*

SE 1/4 NE 1/4 Sec. *34* T. *8* S., R. *4* W., W.M.

Bearing and distance from section or subdivision

corner *1145' W. & 1920' S. from NE cor. Sec. 34.*

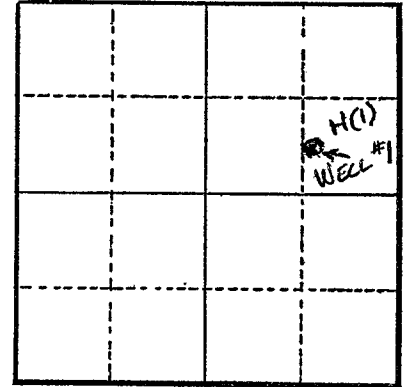

Section *34*

Altitude at well *153 ft.*

TYPE OF WELL: *Drilled* Date Constructed *1944*

Depth drilled *32 ft.* Depth cased *29 ft.*

CASING RECORD:

12 inch from 3 to 32 ft.

FINISH:

AQUIFERS:

WATER LEVEL:

14 ft.

PUMPING EQUIPMENT: Type *F. M. Cent.* H.P. *30*

Capacity *500* G.P.M.

WELL TESTS:

Drawdown _____ ft. after _____ hours _____ G.P.M.

Drawdown _____ ft. after _____ hours _____ G.P.M.

USE OF WATER *Irrigation* Temp. _____ °F., 19_____

SOURCE OF INFORMATION *G. R. Record*

DRILLER or DIGGER _____

ADDITIONAL DATA:

Log *N.A.* Water Level Measurements _____ Chemical Analysis _____ Aquifer Test _____

REMARKS:

Irrigation of 90 acres.