

STATE ENGINEER
Salem, Oregon

OBSERVATION WELL

Polk
3229
Well Record

STATE WELL NO. 8/5W-13H(1)
COUNTY Polk
APPLICATION NO. GR-635

OWNER: ^{STEVE GRASSER}
Milo & ida B. Jensen


MAILING ADDRESS: Rt. 1 Box 343-A

LOCATION OF WELL: Owner's No. 1

CITY AND STATE: Independence, Oregon

SE $\frac{1}{4}$ NE $\frac{1}{4}$ Sec. 13 T. 8 ^{XX} S., R. 5 ^{XX} W., W.M.

Bearing and distance from section or subdivision
corner 450' W. & 200' N. from E $\frac{1}{4}$ cor. of sec. 13

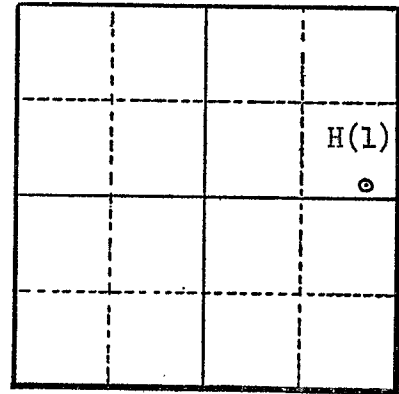

Section 13

Altitude at well 192'

TYPE OF WELL: Drilled Date Constructed July 1951

Depth drilled 98' Depth cased _____

CASING RECORD:
8 inch

FINISH:

AQUIFERS:

WATER LEVEL:
5 feet

PUMPING EQUIPMENT: Type Jacuzzi H.P. 1 $\frac{1}{2}$
Capacity 40 G.P.M.

WELL TESTS:
Drawdown 82 ft. after _____ hours 40 G.P.M.
Drawdown _____ ft. after _____ hours _____ G.P.M.

USE OF WATER Irrigation (5 acres) Temp. _____ °F. _____, 19____

SOURCE OF INFORMATION GR-600

DRILLER or DIGGER Marion West, Salem

ADDITIONAL DATA:

Log NA Water Level Measurements _____ Chemical Analysis _____ Aquifer Test _____

REMARKS: