

STATE ENGINEER  
Salem, Oregon

*Polk*  
*3633*

**OBSERVATION WELL**  
**Well Record**

STATE WELL NO. 8/6W-22F(1)  
COUNTY Polk  
APPLICATION NO. GR-2261

OWNER: Edward Bakke

MAILING ADDRESS:


LOCATION OF WELL: Owner's No. \_\_\_\_\_

CITY AND STATE:

Falls City, Oregon

SE ¼ NW ¼ Sec. 22 T. 8 <sup>NX</sup> S., R. 6 <sup>XX</sup> W., W.M.

Bearing and distance from section or subdivision corner 660' N. & 335' W. from center of sec. 22

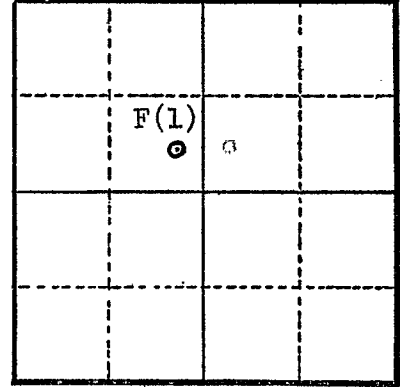

Section 22

Altitude at well \_\_\_\_\_

TYPE OF WELL: Drilled Date Constructed 1951

Depth drilled 79' Depth cased 50'

CASING RECORD:

6 inch

FINISH:

AQUIFERS:

WATER LEVEL:

5 feet

PUMPING EQUIPMENT: Type Goulds jet H.P. 3  
Capacity 100 G.P.M.

WELL TESTS:

Drawdown \_\_\_\_\_ ft. after \_\_\_\_\_ hours \_\_\_\_\_ G.P.M.

Drawdown \_\_\_\_\_ ft. after \_\_\_\_\_ hours \_\_\_\_\_ G.P.M.

USE OF WATER Irrigation ( Temp. \_\_\_\_\_ °F. \_\_\_\_\_, 19\_\_\_\_

SOURCE OF INFORMATION GR- 2158

DRILLER or DIGGER McRae

ADDITIONAL DATA:

Log NA Water Level Measurements \_\_\_\_\_ Chemical Analysis \_\_\_\_\_ Aquifer Test \_\_\_\_\_

REMARKS: