

STATE ENGINEER
Salem, Oregon

Well Record

STATE WELL NO. 8/6W-25R(1)
COUNTY Polk
APPLICATION NO. GR- 72


MAX B. NORTON

OWNER: Ellis H. Breeden *Ray Norton* MAILING ADDRESS: _____

LOCATION OF WELL: Owner's No. 1 CITY AND STATE: Dallas, Oregon

SE 1/4 SE 1/4 Sec. 25 T. 8 N. S., R. 6 W., W.M.

Bearing and distance from section or subdivision corner 594' N. from SE cor. of T. Hart DLC #39
or 650' NW from SE cor. of sec. 25

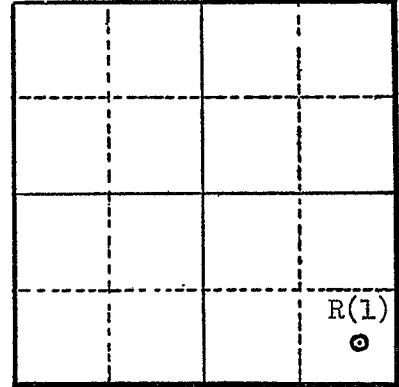

Altitude at well 250'

TYPE OF WELL: Drilled Date Constructed 1948

Depth drilled 52' Depth cased 24'

Section 25

CASING RECORD:

12 inch from 0 to 24 feet. Solid rock to 52' feet

FINISH:

AQUIFERS:

Rock from 25 to 52 feet

WATER LEVEL:

8 feet in 1949

PUMPING EQUIPMENT: Type _____ H.P. _____

Capacity _____ G.P.M.

WELL TESTS:

Drawdown 30 ft. after 8 hours 300 G.P.M.

Drawdown _____ ft. after _____ hours _____ G.P.M.

USE OF WATER Irrigation (16 acres) Temp. _____ °F. _____, 19____

SOURCE OF INFORMATION GR- 76

DRILLER or DIGGER _____

ADDITIONAL DATA:

Log Water Level Measurements _____ Chemical Analysis _____ Aquifer Test _____

REMARKS:

Overburden 0 to 25
Black basalt 25 to 52