

STATE ENGINEER
Salem, Oregon

Well Record

STATE WELL NO. 9/3W-6N
COUNTY Polk
APPLICATION NO. GR-3976

OWNER: V. O. Weathers


MAILING ADDRESS: Route 1, Box 57

LOCATION OF WELL: Owner's No. _____

CITY AND STATE: Independence, Oregon

SW 1/4 SW 1/4 Sec. 6 T. 9 S., R. 3 W., W.M.

Bearing and distance from section or subdivision
corner 8.22 chs. N. 24°18' E. from SW Cor. Sec. 6

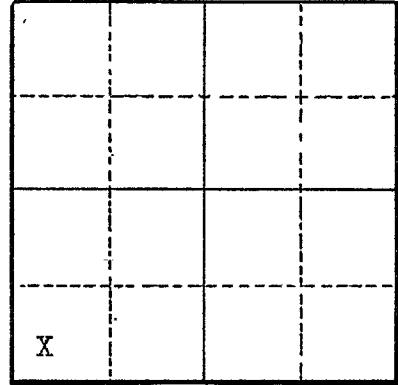

Section 6

Altitude at well _____

TYPE OF WELL: Drilled Date Constructed 1940

Depth drilled 38 ft. Depth cased _____

CASING RECORD:

FINISH:

AQUIFERS:

WATER LEVEL:

PUMPING EQUIPMENT: Type Fairbanks Morse H.P. 25
Capacity 750 G.P.M.

WELL TESTS:
Drawdown 6 ft. after _____ hours 750 G.P.M.
Drawdown _____ ft. after _____ hours _____ G.P.M.

USE OF WATER Irrigation Temp. _____ °F., 19 _____

SOURCE OF INFORMATION Well Registration Statement Cert. # GR-3591

DRILLER or DIGGER _____

ADDITIONAL DATA:

Log _____ Water Level Measurements _____ Chemical Analysis _____ Aquifer Test _____

REMARKS: