

STATE ENGINEER
Salem, Oregon

Well Record


STATE WELL NO. 9/4W-7E³
COUNTY FOLK
APPLICATION NO. GR-2434

OWNER: Mildred Hill DBA Werline Hop Ranch MAILING ADDRESS: Rt. 1, Box 46

LOCATION OF WELL: Owner's No. #1 CITY AND STATE: Independence, Oregon

SW 1/4 NW 1/4 Sec. 7 T. 9 S., R. 4 W., W.M.

Bearing and distance from section or subdivision corner 1450' S. 600' E.

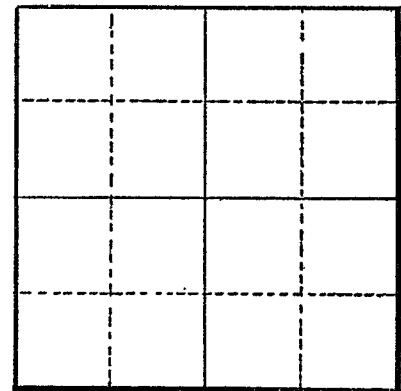

Section

Altitude at well

TYPE OF WELL: Drilled Date Constructed 1949

Depth drilled 36 Depth cased 35

CASING RECORD:

10-inch

FINISH:

10 inch row 5 rows from 29 to 35

AQUIFERS:

Soil, sand, gravel

WATER LEVEL:

16-feet

PUMPING EQUIPMENT: Type Rain o. flow H.P. 40
Capacity 800 G.P.M.

WELL TESTS:

Drawdown 2 ft. after hours Pumping 800 G.P.M.
Drawdown ft. after hours G.P.M.

USE OF WATER Irrigation Temp. °F., 19

SOURCE OF INFORMATION GR-2309

DRILLER or DIGGER

ADDITIONAL DATA:

Log Water Level Measurements Chemical Analysis Aquifer Test

REMARKS:

Heavy soil to 12'
Fine sand 12 - 16
Sand & gravel 16 - 24
Water bearing gravel 24 - 36