

STATE ENGINEER
Salem, Oregon


Well Record *Polk* STATE WELL NO. *9/3W-7B(1)*
36915 COUNTY *Polk*
GR- 1064 APPLICATION NO. *GR- 1104*

OWNER: *John I. Haas, Inc. of Baltimore, Md.* ADDRESS: *Rt. 1, Box 3*

LOCATION OF WELL: Owner's No. *#1* STATE: *Independence, Oregon*

N
S
NW 1/4 NE 1/4 Sec. *7* T. *9* S., R. *3* W., W.M.

Bearing and distance from section or subdivision
corner *S55°15'E, 14.54 ch. from N 1/4 cor. Sec. 7.*

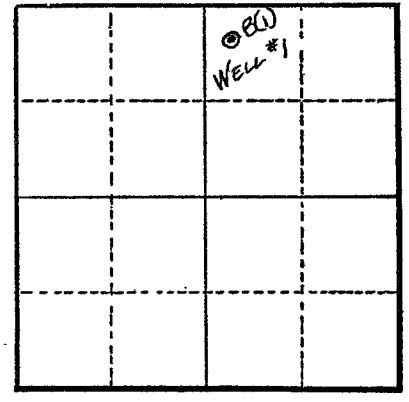

Section *7*

Altitude at well *173 ft.*

TYPE OF WELL: *Drilled* Date Constructed *1949*

Depth drilled *30 ft.* Depth cased *30 ft.*

CASING RECORD:
12 inch.

FINISH:
Perforated - 10 per ft. - slots 5/8 x 8 in. from 14 to 30 ft.

AQUIFERS:

WATER LEVEL:
9.5 ft.

PUMPING EQUIPMENT: Type *F. M. Gent. 4x 5* H.P. *50*
Capacity *900* G.P.M.

WELL TESTS:
Drawdown *4* ft. after *1500* hours G.P.M.
Drawdown _____ ft. after _____ hours G.P.M.

USE OF WATER *Irrigation* Temp. _____ °F., 19____

SOURCE OF INFORMATION *G. R. Record*

DRILLER or DIGGER _____
ADDITIONAL DATA:
Log _____ Water Level Measurements _____ Chemical Analysis _____ Aquifer Test _____

REMARKS:
Log: River bottom soil 0 to 8 ft.
Sand & gravel 8 to 30 ft.

Irrigation of 133 acres.