

STATE ENGINEER
Salem, Oregon

Well Record

Polk
3697

STATE WELL NO. 9/3W-7E(1)
COUNTY Polk
APPLICATION NO. GR- 665

OWNER: Eldon S. Park


MAILING ADDRESS: Rt. 1 Box 48

LOCATION OF WELL: Owner's No.

CITY AND STATE: Independence, Oregon

SW 1/4 NW 1/4 Sec. 7 T. 9 S., R. 3 W., W.M.

Bearing and distance from section or subdivision
corner 1050' E. & 200' N. from W 1/4 cor. of sec. 7

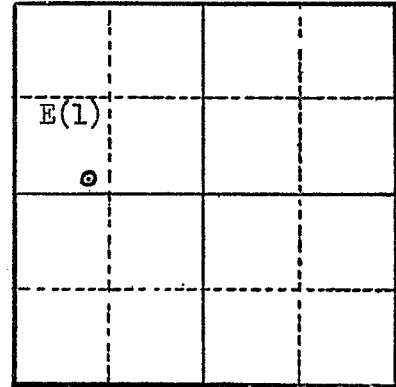

Section7.....

Altitude at well 170'

TYPE OF WELL: Drilled Date Constructed Apr. 1941

Depth drilled 32' Depth cased 32'

CASING RECORD:
6 inch

FINISH:

AQUIFERS:

WATER LEVEL:
23 feet

PUMPING EQUIPMENT: Type Denver centrifugal H.P. 7 1/2
Capacity 175 G.P.M.

WELL TESTS:
Drawdown ft. after hours G.P.M.
Drawdown ft. after hours G.P.M.

USE OF WATER Irrigation (9 1/2 acres) Temp. °F., 19

SOURCE OF INFORMATION GR- 639

DRILLER or DIGGER

ADDITIONAL DATA:
Log Water Level Measurements Chemical Analysis Aquifer Test

REMARKS:

Soil & clay 0 to 8
Sand & gravel mixed/ clay 8 to 14
Sand & gravel 14 to 23
Sand & gravel (WB) 23 to 32

For Official Use Only by The Oregon Water Resources Department:

Received Date:

7-23-04

County Well Log ID #

Polk 3697

Well Identification Tag #

L-71924

71924

WELL IDENTIFICATION APPLICATION FORM

INSTRUCTIONS ARE IN THE ACCOMPANYING "DEAR LANDOWNER" LETTER. FOR SHARED WELLS PLEASE SEE THE 3RD PARAGRAPH FROM THE TOP IN THE LETTER. Your ID Tag will be mailed out in approximately 10 days from the date we receive your application.)

**BUYER OR CURRENT LANDOWNER (For the property that the well is located on. The Well ID tag will be sent to this address unless otherwise specified here.)

Landowner's or Buyer's Name: LINDEN PARK + SANDRA PARK

Mailing Address: 8645 HIGHLAND Rd.

City: INDEPENDENCE State: OR Zip: 97351 Phone: (503) 838-1405

**WELL LOCATION:

County: POLK Well # 1 (if multiple wells exist on same property-ie: well #1,#2, etc.)

Township: 9 North or South (circle one) Range: 3 East or West (circle one) Section: 7 1/4 1/4 (If known)

Tax Lot #: 400 Type of Well: water supply? IRRIG monitoring? (Not the same as the tax acct.#) (Ex: domestic or irrigation use) (Ex: monitoring water for contaminants)

Address of Well: 3955 WIGRICH Rd. INDEPENDENCE 97351 (Number) (Street) (City) (Zip)

(Optional): Does this well have a formal water right associated with it? Yes: [checked] No: (If unknown you may want to contact the Water Rights Group at 503-986-0945 for research)

If Yes: Application #: Permit #: Certificate #: GR 639

(Optional): Latitude Longitude (May sometimes be obtained from Well Log Report)

**WELL INFORMATION: (Important note: If attaching a well log you obtained from our web-site please be certain that you have the correct log. Simply matching the tax lot number isn't enough. See attached instructions for assistance. If a well report is not available please complete as much of the following as possible, at a minimum the prior landowner names going back until around the time the well would have been drilled. Prior landowner names can be obtained from the County Assessor - see instructions.)

Reg. # CERTIFICATE # GR 665 GR 639 Start Card # from well log report if known: Approx. Well Construction Date: APRIL 1941

Well Constructor if known: HAMILTON well DRILLING

Name of Land Owner at Time of Construction (or prior landowners, going back in time to when well was constructed - contact your county assessor for list)

ELDON PARK

Well Depth (in feet): 32 Static Water Level (in feet): 23 Diameter of Exposed Well Casing (in inches): 6

Please Return Completed Form to: Well ID Program, Oregon Water Resources Department 725 Summer St. NE, Suite A, Salem, OR 97301-1271, or fax to 503-986-0902

RECEIVED (App10-03) JUL 23 2004 WATER RESOURCES DEPT SALEM, OREGON