

STATE ENGINEER
Salem, Oregon

Well Record

Polk
3708
STATE WELL NO. 9/4W-1J
COUNTY Polk
APPLICATION NO. GR-3977

OWNER: V. O. Weathers


MAILING ADDRESS: Route 1, Box 57

LOCATION OF WELL: Owner's No. _____

CITY AND STATE: Independence, Oregon

NE 1/4 SE 1/4 Sec. 1 T. 9 S., R. 4 W., W.M.

Bearing and distance from section or subdivision corner 20.16 chs. N. 2°37' W. from SE Cor. Sec. 1

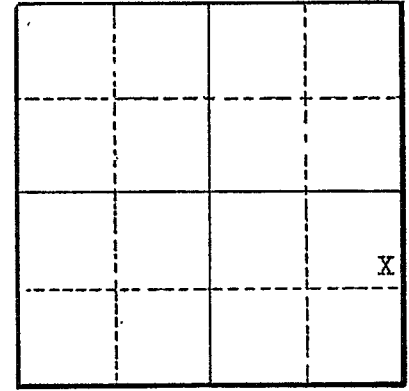

Section 1

Altitude at well _____

TYPE OF WELL: Drilled Date Constructed 1954

Depth drilled 32 ft. Depth cased _____

CASING RECORD:

FINISH:

AQUIFERS:

WATER LEVEL:

14 ft. below surface

PUMPING EQUIPMENT: Type Pacific H.P. 20
Capacity 500 G.P.M.

WELL TESTS:

Drawdown 4 ft. after _____ hours 500 G.P.M.
Drawdown _____ ft. after _____ hours _____ G.P.M.

USE OF WATER Irrigation Temp. _____ °F. _____, 19____

SOURCE OF INFORMATION Well Registration Statement Cert. # GR-3592

DRILLER or DIGGER _____

ADDITIONAL DATA:

Log _____ Water Level Measurements _____ Chemical Analysis _____ Aquifer Test _____

REMARKS: