

STATE ENGINEER  
Salem, Oregon

# Well Record

STATE WELL NO. 9/4W - 1N  
COUNTY POLK  
APPLICATION NO. GR-2045

G 7051

3710

OWNER: Gordon Hadley


MAILING ADDRESS: Rt. 1, Box 53-A

LOCATION OF WELL: Owner's No. #2

CITY AND STATE: Independence, Oregon

SW  $\frac{1}{4}$  SW  $\frac{1}{4}$  Sec. 1 T. 9 N. S., R. 4 E. W., W.M.

Bearing and distance from section or subdivision corner 900' E. and 625' N.

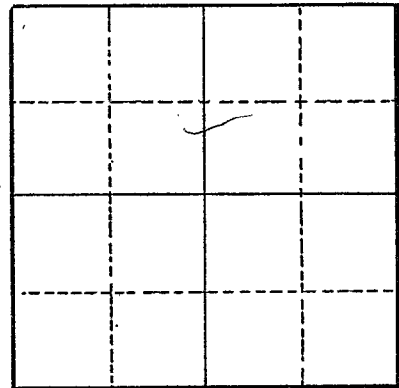

Section

Altitude at well

TYPE OF WELL: Drilled Date Constructed 1948

Depth drilled 28 Depth cased 28

### CASING RECORD:

10-inch

### FINISH:

### AQUIFERS:

Sand & gravel

### WATER LEVEL:

8 to 16 feet

PUMPING EQUIPMENT: Type Gardner Denver Centrifugal H.P. 100  
Capacity 800 G.P.M.

### WELL TESTS:

Drawdown 12 to 17 ft. after \_\_\_\_\_ hours Pumping 725 G.P.M.  
Drawdown \_\_\_\_\_ ft. after \_\_\_\_\_ hours \_\_\_\_\_ G.P.M.

USE OF WATER Irrigation Temp. \_\_\_\_\_ °F., 19 \_\_\_\_\_

SOURCE OF INFORMATION GR-1971

DRILLER or DIGGER Art Clinton

### ADDITIONAL DATA:

Log  Water Level Measurements \_\_\_\_\_ Chemical Analysis \_\_\_\_\_ Aquifer Test \_\_\_\_\_

### REMARKS:

Sand and gravel