

STATE ENGINEER  
Salem, Oregon

# Well Record

STATE WELL NO. 9/4W-10  
COUNTY Polk  
APPLICATION NO. GR-1697

GR-1646

*Polk*  
*5218*

OWNER: Alfred M. Hafner


MAILING ADDRESS: Rt. 1, Box 57

LOCATION OF WELL: Owner's No. #1

CITY AND STATE: Independence, Oregon

SW 1/4 SE 1/4 Sec. 1 T. 9 S., R. 4 W., W.M.

Bearing and distance from section or subdivision corner 1335' W. & 760' N. from SE cor. Sec. 1

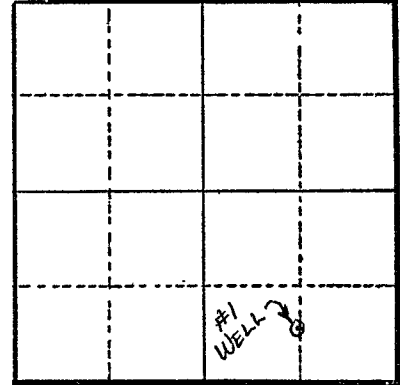

Section 1

Altitude at well 160'

TYPE OF WELL: Drilled Date Constructed Prior to 1941

Depth drilled 35' Depth cased 35'

CASING RECORD:  
10"

FINISH:  
Perforated

AQUIFERS:  
Sand & gravel

WATER LEVEL:  
10'

PUMPING EQUIPMENT: Type F. M. 4" H.P. 50  
Capacity 800 G.P.M.

WELL TESTS:  
Drawdown \_\_\_\_\_ ft. after \_\_\_\_\_ hours \_\_\_\_\_ G.P.M.  
Drawdown \_\_\_\_\_ ft. after \_\_\_\_\_ hours \_\_\_\_\_ G.P.M.

USE OF WATER Irrigation Temp. \_\_\_\_\_ °F., 19\_\_

SOURCE OF INFORMATION GR Record

DRILLER or DIGGER Art Clinton

ADDITIONAL DATA:  
Log N.A. Water Level Measurements \_\_\_\_\_ Chemical Analysis \_\_\_\_\_ Aquifer Test \_\_\_\_\_

REMARKS:  
Irrigation of 30 acres