

STATE ENGINEER
Salem, Oregon


Well Record *Polk* STATE WELL NO. *9/W-10*
COUNTY *Polk*
GR- 1647 *3713* APPLICATION NO. *GR-1698*

OWNER: *Alferd M. Haener* MAILING ADDRESS: *Rt. 1, Box 57*

LOCATION OF WELL: Owner's No. *#2* CITY AND STATE: *Independence, Oregon*

N. XE
SW 1/4 SE 1/4 Sec. *1* T. *9* S., R. *4* W., W.M.

Bearing and distance from section or subdivision corner *1896' W. & 1660' N. & 210' W. from SE cor. of Sec. 1*

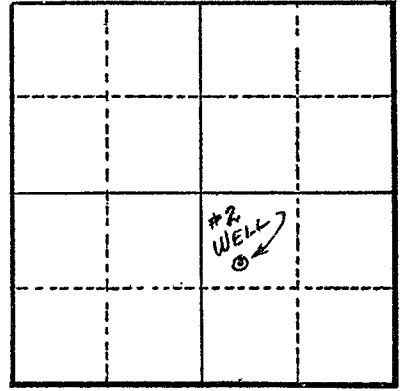

Section *1*

Altitude at well *160'*

TYPE OF WELL: *Drilled* Date Constructed *1941*

Depth drilled *35'* Depth cased *35'*

CASING RECORD:
10"

FINISH:
Perforated

AQUIFERS:
Sand & gravel

WATER LEVEL:
12'

PUMPING EQUIPMENT: Type *F. B. 4"* H.P. *50*
Capacity *800* G.P.M.

WELL TESTS:
Drawdown ft. after hours G.P.M.
Drawdown ft. after hours G.P.M.

USE OF WATER *Irrigation* Temp. °F., 19

SOURCE OF INFORMATION *GR Record*

DRILLER or DIGGER *Art. Clinton*

ADDITIONAL DATA:
Log *N.A.* Water Level Measurements Chemical Analysis Aquifer Test

REMARKS:
Irrigation of 30 acres.