

STATE ENGINEER
Salem, Oregon

Well Record *Polk* STATE WELL NO. *9/LW-10*
COUNTY *Polk*
GR- 1648 *374* APPLICATION NO. GR- 1699

OWNER: *Alfred M. Haener* MAILING ADDRESS: *Rt. 1, Box 57*

LOCATION OF WELL: Owner's No. *#3* CITY AND STATE: *Independence, Oregon*


XX *XX*
SW 1/4 SE 1/4 Sec. *1* T. *9* S., R. *4* W., W.M.

Bearing and distance from section or subdivision corner *1896' W. & 43' N. from SE cor. Sec. 1*

Altitude at well *160'*

TYPE OF WELL: *Drilled* Date Constructed *1941*

Depth drilled *37'* Depth cased *37'*

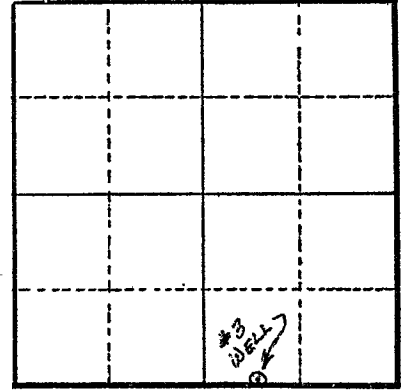

Section *1*

CASING RECORD:

~~XXXXXXXXXX~~ *12"*

FINISH:

Perforated

AQUIFERS:

Sand & gravel

WATER LEVEL:

11'

PUMPING EQUIPMENT: Type *F. M. 4"* H.P. *50*

Capacity *800* G.P.M.

WELL TESTS:

Drawdown _____ ft. after _____ hours _____ G.P.M.

Drawdown _____ ft. after _____ hours _____ G.P.M.

USE OF WATER *Irrigation* Temp. _____ °F. _____, 19____

SOURCE OF INFORMATION *GR Record*

DRILLER or DIGGER *Art Clinton*

ADDITIONAL DATA:

Log *N.A.* Water Level Measurements _____ Chemical Analysis _____ Aquifer Test _____

REMARKS:

Irrigation of 30 acres.