

OWNER: Robert J. Fitts


MAILING ADDRESS:

LOCATION OF WELL: Owner's No. 5

CITY AND STATE: Independence, Oregon

NE ¼ SE ¼ Sec. 2 T. 9 S., R. 4 W., W.M.

Bearing and distance from section or subdivision corner 1200' E. from center of sec. 2 at N. ¼, ¼ cor. of SE¼ of sec. 2

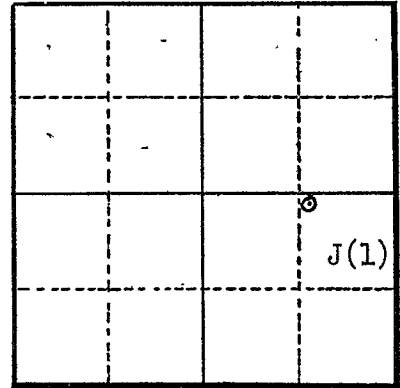

Altitude at well 150'

TYPE OF WELL: Drilled Date Constructed Prior 1935

Depth drilled 30' Depth cased 30'

Section 2

CASING RECORD:
10 inch

FINISH:

AQUIFERS:

WATER LEVEL:
15 feet

PUMPING EQUIPMENT: Type F. M. H.P. 40-50
Capacity 900 G.P.M.

WELL TESTS:
Drawdown ft. after hours G.P.M.
Drawdown ft. after hours G.P.M.

USE OF WATER Irrigation (93 acres) Temp. °F., 19
SOURCE OF INFORMATION GR- 56

DRILLER or DIGGER

ADDITIONAL DATA:
Log NA Water Level Measurements Chemical Analysis Aquifer Test

REMARKS: