

STATE ENGINEER  
Salem, Oregon

# Well Record

STATE WELL NO. 9/LW-20(1)  
COUNTY Polk  
APPLICATION NO. GR- 65

OWNER: Robert J. Fitts

MAILING  
ADDRESS:


LOCATION OF WELL: Owner's No. 4

CITY AND  
STATE:

Independence, Oregon

SW 1/4 SE 1/4 Sec. 2 T. 9 S., R. 4 W., W.M.

Bearing and distance from section or subdivision  
corner 2700' NW of SE cor. of sec. 2

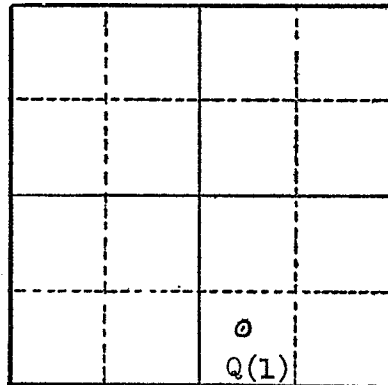

Altitude at well 150'

TYPE OF WELL: Drilled Date Constructed Prior 1935

Depth drilled 30' Depth cased 30'

Section 2

CASING RECORD:  
12 inch

FINISH:

AQUIFERS:

WATER LEVEL:  
15 feet

PUMPING EQUIPMENT: Type F.M. H.P. 10-50  
Capacity 900 G.P.M.

WELL TESTS:  
Drawdown ..... ft. after ..... hours ..... G.P.M.  
Drawdown ..... ft. after ..... hours ..... G.P.M.

USE OF WATER Irrigation (75 acres) Temp. ..... °F. ...., 19.....

SOURCE OF INFORMATION GR- 56

DRILLER or DIGGER

ADDITIONAL DATA:

Log NA Water Level Measurements ..... Chemical Analysis ..... Aquifer Test .....

REMARKS: