

STATE ENGINEER  
Salem, Oregon

# Well Record

STATE WELL NO. 9/4W-3C  
COUNTY Folk  
APPLICATION NO. GR-3107

*POK*  
*375*

OWNER: Frank B. and Rose I. Krauger


MAILING ADDRESS: Route 1, Box 18

LOCATION OF WELL: Owner's No. 2

CITY AND STATE: Independence, Oregon

NE  $\frac{1}{4}$  NW  $\frac{1}{4}$  Sec. 3 T. 9 S., R. 4 W., W.M.

Bearing and distance from section or subdivision corner S. 69° 10' E., 2630 feet

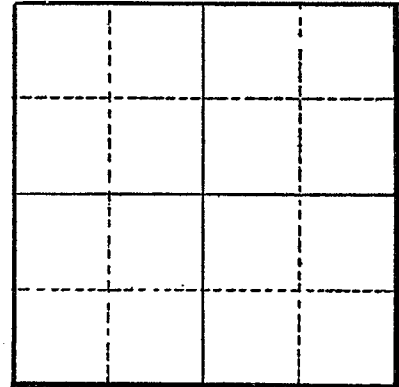

Section .....

Altitude at well .....

TYPE OF WELL: Driven Date Constructed 1943

Depth drilled 25 feet Depth cased .....

CASING RECORD:

FINISH:

Perforated 8'

AQUIFERS:

WATER LEVEL:

12 feet

PUMPING EQUIPMENT: Type Fairbanks-Morse H.P. 15  
Capacity 375 G.P.M.

WELL TESTS:

Drawdown 6 ft. after ..... hours ..... G.P.M.  
Drawdown ..... ft. after ..... hours ..... G.P.M.

USE OF WATER Irrigation Temp. ..... °F. ...., 19.....

SOURCE OF INFORMATION GR-2915

DRILLER or DIGGER .....

ADDITIONAL DATA:

Log ..... Water Level Measurements ..... Chemical Analysis ..... Aquifer Test .....

REMARKS: