

STATE ENGINEER
Salem, Oregon

Well Record

STATE WELL NO. 9/4W-3D
COUNTY Polk
APPLICATION NO. GR-3106

OWNER: Frank B. and Rose I. Krauger


MAILING ADDRESS: Route 1, Box 18

LOCATION OF WELL: Owner's No. #1

CITY AND STATE: Independence, Oregon

NW 1/4 NW 1/4 Sec. 3 T. 9 N. S., R. 4 W., W.M.

Bearing and distance from section or subdivision
corner S. 31° 50' E., 920 feet

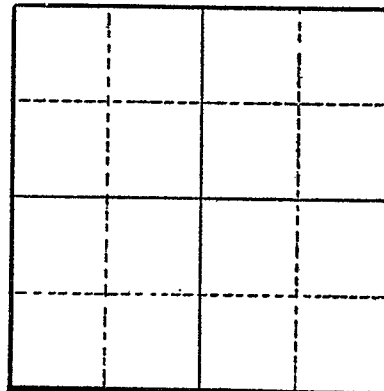

Section

Altitude at well

TYPE OF WELL: Drilled Date Constructed 1943

Depth drilled 35 feet Depth cased

CASING RECORD:

FINISH:

8 ft. perforated casing 1/4"

AQUIFERS:

Sand and gravel

WATER LEVEL:

24 feet

PUMPING EQUIPMENT: Type Fairbanks-Morse

H.P. 10

Capacity G.P.M.

WELL TESTS:

Drawdown 6 ft. after hours G.P.M.

Drawdown ft. after hours G.P.M.

USE OF WATER Irrigation

Temp. °F., 19

SOURCE OF INFORMATION GR-2914

DRILLER or DIGGER Bill Hamilton Albany, Oregon

ADDITIONAL DATA:

Log Water Level Measurements Chemical Analysis Aquifer Test

REMARKS:

Sand and gravel

POLK 3741



Oregon Water Resources Department
725 Summer Street NE, Suite A
Salem Oregon 97301
(503) 986-0900
www.oregon.gov/owrd

Application for Well ID Number

RECEIVED

APR 20 2020

OWRD

Do not complete if the well already has a Well Identification Number.

I. OWNER INFORMATION

Current Owner Name (please print): Eric and Susan Borst

Mailing Address: 7625 Buena Vista Rd

City, State, Zip: Independence, OR 97351

Mail Well ID to: SAME AS ABOVE In Care Of (C/O)

Name & Address: _____

City, State, Zip: _____

II. WELL LOCATION INFORMATION (Please fill out as completely as possible)

Township: 9 S (North / South) Range: 4 W (East / West) Section: 3 NW 1/4 of the NW 1/4

Tax Lot (usually last 3-5 numbers of Tax Map #): 300 County Polk

GPS Coordinates: _____

Street Address of Well, City: 7625 Buena Vista Rd., Independence, OR 97351

If the property had a different street address in the past: _____

III. GENERAL WELL INFORMATION (Please fill out as completely as possible, AND attach copy of Well Report, if available)

Use of Well (domestic, irrigation, commercial, industrial, monitoring): Domestic

Date Well Constructed (or property built): 1915 Total Well Depth: 35' Casing Diameter: 10"

Owner at time the well was constructed (if known): _____ Well Report # (if known): _____

Other Information: _____

SUBMITTED BY (please print): Eric Borst

PHONE: 503-838-6526 EMAIL &/or FAX: borsts@wou.edu

Send application to: Oregon Water Resources Department 725 Summer St NE, Suite A, Salem, Oregon 97301; or fax to (503) 986-0902. Applications are processed in the order they are received, and Well ID Numbers are mailed within 4-5 business days.

Previous landowners - Krauger, Gamble/Marae, Smith/Amidon

For Official Use Only by the Oregon Water Resources Department:

Received Date:

4-20-2020

Well Report Number:

POLK 3741

Well Identification #:

L-138102