

STATE ENGINEER  
Salem, Oregon

# Well Record

Polk

STATE WELL NO. 9/LW-3J

COUNTY Polk

GR- 1276

3743

APPLICATION NO. GR- 1321

OWNER: Elmer & Gertrude E. Miller


MAILING ADDRESS: Rt. 1, Box 22 A

LOCATION OF WELL: Owner's No. #1

CITY AND STATE: Independence, Oregon

NE 1/4 SE 1/4 Sec. 3 T. 9 N. S., R. 4 W., W.M.

Bearing and distance from section or subdivision corner 2150' N. & 250' W. from SE cor. Sec. 3.

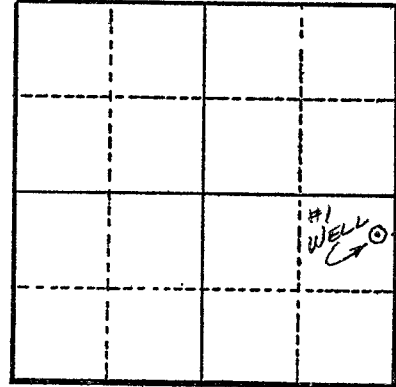

Section 3

Altitude at well

TYPE OF WELL: Drilled Date Constructed 1946

Depth drilled 50 ft. Depth cased 50 ft.

CASING RECORD:

12 inch

FINISH:

AQUIFERS:

WATER LEVEL:

16 ft.

PUMPING EQUIPMENT: Type A. C. Cent.

H.P. 20

Capacity 350 G.P.M.

WELL TESTS:

Drawdown 2 ft. after 380 hours G.P.M.

Drawdown ft. after hours G.P.M.

USE OF WATER Irrigation Temp. °F. 19

SOURCE OF INFORMATION G. R. Record

DRILLER or DIGGER Art Clinton

ADDITIONAL DATA:

Log N.A. Water Level Measurements Chemical Analysis Aquifer Test

REMARKS:

Irrigation of 27 acres.