

STATE ENGINEER
Salem, Oregon

Well Record

STATE WELL NO. 9/141-31(2)

COUNTY Polk

GR- 1275 3744

APPLICATION NO. GR-1320

OWNER: Elmer & Gertrude E. Miller

MAILING

ADDRESS: Rt. 1, Box 22A

LOCATION OF WELL: Owner's No. #2


CITY AND

STATE: Independence, Oregon

NE 1/4 SE 1/4 Sec. 3 T. 9 S., R. 4 W., W.M.

Bearing and distance from section or subdivision

corner 1800' N. & 250' W. from SE cor. Sec. 3.

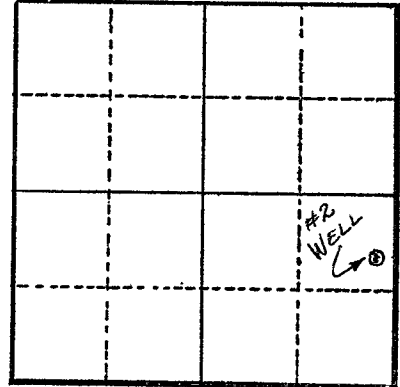

Section 3

Altitude at well _____

TYPE OF WELL: Drilled Date Constructed 1946

Depth drilled 50 ft. Depth cased 50 ft.

CASING RECORD:

12 inch

FINISH:

AQUIFERS:

WATER LEVEL:

16 ft.

PUMPING EQUIPMENT: Type Jacuzzi Cent.

H.P. 10

Capacity 350 G.P.M.

WELL TESTS:

Drawdown 3 ft. after _____ hours 480 G.P.M.

Drawdown _____ ft. after _____ hours _____ G.P.M.

USE OF WATER Irrigation

Temp. _____ °F. 19

SOURCE OF INFORMATION G. R. Record

DRILLER or DIGGER Art Clinton

ADDITIONAL DATA:

Log N.A. Water Level Measurements _____ Chemical Analysis _____ Aquifer Test _____

REMARKS:

Irrigation of 35 acres.